


MW4

1 LOCATION OF WATER WELL: Fraction NE 1/4 NE 1/4 NE 1/4 Section Number 17 Township Number T 12 S Range Number R 23  
 County: Trego

Distance and direction from nearest town or city street address of well if located within city?  
I-70 & 283 Hwy, Wakeeney, Kansas

2 WATER WELL OWNER: Wakeeney Travel Plaza Attn: Larry Triplett Board of Agriculture, Division of Water Resources  
 RR#, St. Address, Box # Box 647 Salina, KS 67402 Application Number: -----  
 City, State, ZIP Code

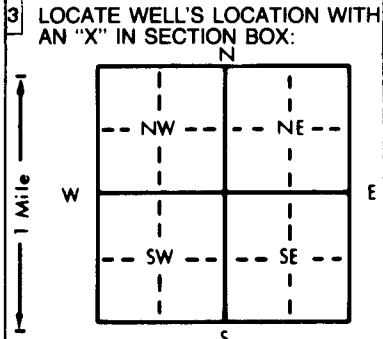

4 DEPTH OF COMPLETED WELL 98 ft. ELEVATION: -----  
 Depth(s) Groundwater Encountered 1 81.5 ft. 2 ----- ft. 3 ----- ft.  
 WELL'S STATIC WATER LEVEL 82.77 ft. below land surface measured on 6/14/95 mo/day/yr  
 Pump test data: Well water was ----- ft. after ----- hours pumping ----- gpm  
 Est. Yield ----- gpm: Well water was ----- ft. after ----- hours pumping ----- gpm  
 Bore Hole Diameter 8.625 in. to 98 ft. and ----- in. to ----- ft.  
 WELL WATER TO BE USED AS: 5 Public water supply 8 Air conditioning 11 Injection well  
 1 Domestic 3 Feedlot 6 Oil field water supply 9 Dewatering 12 Other (Specify below)  
 2 Irrigation 4 Industrial 7 Lawn and garden only 10 Monitoring well MW-4  
 Was a chemical/bacteriological sample submitted to Department? Yes ----- No X; If yes, mo/day/yr sample was submitted -----  
 Water Well Disinfected? Yes ----- No X

5 TYPE OF BLANK CASING USED: 5 Wrought iron 8 Concrete tile CASING JOINTS: Glued ----- Clamped -----  
 1 Steel 3 RMP (SR) 6 Asbestos-Cement 9 Other (specify below) Welded -----  
2 PVC 4 ABS 7 Fiberglass Threaded X  
 Blank casing diameter 2 in. to ----- ft. Dia ----- in. to ----- ft. Dia ----- in. to ----- ft.  
 Casing height above land surface 0 in., weight SCH 40 PVC lbs./ft. Wall thickness or gauge No. -----  
 TYPE OF SCREEN OR PERFORATION MATERIAL: 7 PVC 10 Asbestos-cement  
 1 Steel 3 Stainless steel 5 Fiberglass 8 RMP (SR) 11 Other (specify) -----  
 2 Brass 4 Galvanized steel 6 Concrete tile 9 ABS 12 None used (open hole)  
 SCREEN OR PERFORATION OPENINGS ARE: 5 Gauzed wrapped 8 Saw cut 11 None (open hole)  
 1 Continuous slot 3 Mill slot 6 Wire wrapped 9 Drilled holes  
 2 Louvered shutter 4 Key punched 7 Torch cut 10 Other (specify) -----  
 SCREEN-PERFORATED INTERVALS: From 73 ft. to 98 ft., From ----- ft. to ----- ft.  
SAND From ----- ft. to ----- ft., From ----- ft. to ----- ft.  
 GRAVEL PACK INTERVALS: From 71 ft. to 98 ft., From ----- ft. to ----- ft.  
 From ----- ft. to ----- ft., From ----- ft. to ----- ft.

6 GROUT MATERIAL: 1 Neat cement 2 Cement grout 3 Bentonite 4 Other -----  
 Grout Intervals: From 0 ft. to 70 ft., From 70 ft. to 71 ft., From ----- ft. to ----- ft.  
 What is the nearest source of possible contamination: 10 Livestock pens 14 Abandoned water well  
 1 Septic tank 4 Lateral lines 7 Pit privy 11 Fuel storage 15 Oil well/Gas well  
 2 Sewer lines 5 Cess pool 8 Sewage lagoon 12 Fertilizer storage 16 Other (specify below)  
 3 Watertight sewer lines 6 Seepage pit 9 Feedyard 13 Insecticide storage Contaminated site  
 Direction from well? ----- How many feet? -----

FROM	TO	LITHOLOGIC LOG	FROM	TO	PLUGGING INTERVALS
GL	1.00	Asphalt			Flush Mount Wai
1.00	3.00	Fill, silty clay			Don Taylor
3.00	14.00	Silty clay (CL)			5/5/95
14.00	20.00	Silty clay (CL)			
20.00	30.00	Silty sand			
30.00	38.00	Caliche, fine-med grain,			
38.00	44.00	Silty sand, ine-med grain			
44.00	60.00	Sand, fine-med grain, some silts/clays			
60.00	70.00	Sand, fine-med grain, some coarse			
70.00	80.00	Sand, fine-course grain			
80.00	98.00	Sand, fine-course, gravel			
98.00	TD	End of Borehole			

7 CONTRACTOR'S OR LANDOWNER'S CERTIFICATION: This water well was (1) constructed, (2) reconstructed, or (3) plugged under my jurisdiction and was completed on (mo/day/year) 6/1/95 and this record is true to the best of my knowledge and belief. Kansas Water Well Contractor's License No. 479 This Water Well Record was completed on (mo/day/yr) 6/15/95 under the business name of Associated Environmental, Inc. by (signature) Dee Johnson for Grogan Ebberts

INSTRUCTIONS: Use typewriter or ball point pen. PLEASE PRESS FIRMLY and PRINT clearly. Please fill in blanks, underline or circle the correct answers. Send top three copies to Kansas Department of Health and Environment, Bureau of Water, Topeka, Kansas 66620-0001. Telephone: 913-296-5545. Send one to WATER WELL OWNER and retain one for your records.

OFFICE USE ONLY  
T  
R  
EW  
SEC.