


MW 7

1 LOCATION OF WATER WELL: County: Trego Fraction NE 1/4 NE 1/4 NE 1/4 Section Number 17 Township Number T 12 S Range Number R 23 EW

Distance and direction from nearest town or city street address of well if located within city? I-70 & 283 Hwy, Wakeeney, Kansas

2 WATER WELL OWNER: Wakeeney Travel Plaza Attn: Larry Triplett Board of Agriculture, Division of Water Resources City, State, ZIP Code Box 647 Salina, KS 67402 Application Number: -----

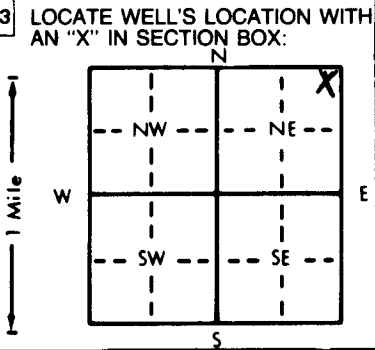

4 DEPTH OF COMPLETED WELL 95 ft. ELEVATION: ----- Depth(s) Groundwater Encountered 1 79.39 ft. 2 ----- ft. 3 ----- ft. WELL'S STATIC WATER LEVEL 79.39 ft. below land surface measured on mo/day/yr 6/14/95

5 TYPE OF BLANK CASING USED: 2 PVC 3 RMP (SR) 4 ABS 5 Wrought iron 6 Asbestos-Cement 7 Fiberglass 8 Concrete tile 9 Other (specify below) 10 Asbestos-cement 11 Other (specify) 12 None used (open hole) Blank casing diameter 2 in. to 6.9 ft. Dia SCH 40 PVC Casing height above land surface 0 in., weight lbs./ft. Wall thickness or gauge No. TYPE OF SCREEN OR PERFORATION MATERIAL: 7 PVC 10 Asbestos-cement 11 Other (specify) SCREEN OR PERFORATION OPENINGS ARE: 3 Mill slot 7 Torch cut 10 Other (specify) SCREEN-PERFORATED INTERVALS: From 6.9 ft. to 9.4 ft. SAND GRAVEL PACK INTERVALS: From 66.5 ft. to 9.5 ft.

6 GROUT MATERIAL: 2 Cement grout 3 Bentonite 4 Other Grout Intervals: From 0 ft. to 64.5 ft. From 64.5 ft. to 66.5 ft. From ----- ft. to ----- ft. What is the nearest source of possible contamination: 16 Other (specify below) Contaminated site

Table with columns: FROM, TO, LITHOLOGIC LOG, FROM, TO, PLUGGING INTERVALS. Rows include: GL 0.50 Asphalt; 0.50 18.00 Silty clay (CL); 18.00 24.00 Clayey sand (SM); 24.00 30.00 Sand (SP) fine grain; 30.00 40.00 Silty clay, fine-med grain sand; 40.00 50.00 Silty sand, fine-course grain; 50.00 62.00 Sand (SP) fine grain; 62.00 64.00 Caliche; 64.00 95.00 Sand, fine to med grain; 95.00 TD End of Borehole. Plugging intervals: Flush Mount Wai Don Taylor 5/5/95

7 CONTRACTOR'S OR LANDOWNER'S CERTIFICATION: This water well was (1) constructed, (2) reconstructed, or (3) plugged under my jurisdiction and was completed on (mo/day/year) 6/13/95 and this record is true to the best of my knowledge and belief. Kansas Water Well Contractor's License No. 479 This Water Well Record was completed on (mo/day/yr) 6/15/95 under the business name of Associated Environmental, Inc. by (signature) Johnson for Bryan Ebberts

INSTRUCTIONS: Use typewriter or ball point pen. PLEASE PRESS FIRMLY and PRINT clearly. Please fill in blanks, underline or circle the correct answers. Send top three copies to Kansas Department of Health and Environment, Bureau of Water, Topeka, Kansas 66620-0001. Telephone: 913-296-5545. Send one to WATER WELL OWNER and retain one for your records.

OFFICE USE ONLY T R E W SEC.