


1 LOCATION OF WATER WELL: Fraction **SW ¼ NW ¼ NW ¼** Section Number **16** Township Number **T 12 S** Range Number **R 23 E**
 County: **Trego**

Distance and direction from nearest town or city street address of well if located within city?

I-70 & K-283 - Wakeeney, Kansas

2 WATER WELL OWNER: **The Service Oil Company**
 RR#, St. Address, Box # : **P.O. Box 446** Board of Agriculture, Division of Water Resources
 City, State, ZIP Code : **Colby, Kansas 67701** Application Number:

3 LOCATE WELL'S LOCATION WITH AN "X" IN SECTION BOX:

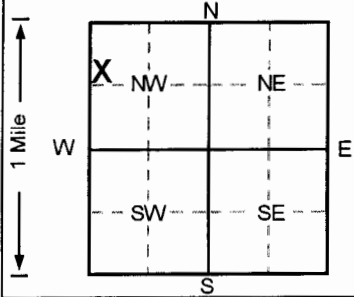

4 DEPTH OF COMPLETED WELL **95** ft. ELEVATION: **2447.48**
 Depth(s) Groundwater Encountered 1. **999** ft. 2. _____ ft. 3. _____ ft.
 WELL'S STATIC WATER LEVEL **81.29** ft. below land surface measured on mo/day/yr **7/11/96**
 Pump test data: Well water was **NA** ft. after _____ hours pumping _____ gpm
 Est. Yield **NA** gpm: Well water was _____ ft. after _____ hours pumping _____ gpm
 Bore Hole Diameter **8** in. to **95** ft., and _____ in. to _____ ft.
 WELL WATER TO BE USED AS: 5 Public water supply 8 Air conditioning 11 Injection well
 1 Domestic 3 Feedlot 6 Oil field water supply 9 Dewatering 12 Other (Specify below)
 2 Irrigation 4 Industrial 7 Lawn and garden only **10** Monitoring well
 Was a chemical/bacteriological sample submitted to Department? Yes _____ No ; If yes, mo/day/yr sample was submitted
 Water Well Disinfected? Yes _____ No

5 TYPE OF BLANK CASING USED: 1 Steel 3 RMP (SR) 5 Wrought iron 8 Concrete tile CASING JOINTS: Glued _____ Clamped _____
2 PVC 4 ABS 7 Fiberglass _____ Welded _____
 Blank casing diameter **2** in. to **70** ft., Dia _____ in. to _____ ft., Dia _____ in. to _____ ft.
 Casing height above land surface **-1.56** in., weight _____ lbs./ft. Wall thickness or gauge No. **Sch. 40**
 TYPE OF SCREEN OR PERFORATION MATERIAL **7** PVC 10 Asbestos-cement
 1 Steel 3 Stainless steel 5 Fiberglass 8 RMP (SR) 11 Other (specify) _____
 2 Brass 4 Galvanized steel 6 Concrete tile 9 ABS 12 None used (open hole)
 SCREEN OR PERFORATION OPENINGS ARE: 5 Gauzed wrapped 8 Saw cut 11 None (open hole)
 1 Continuous slot **3** Mill slot 6 Wire wrapped 9 Drilled holes
 2 Louvered shutter 4 Key punched 7 Torch cut 10 Other (specify) _____
 SCREEN-PERFORATED INTERVALS: From **70** ft. to **95** ft., From _____ ft. to _____ ft.
 From _____ ft. to _____ ft., From _____ ft. to _____ ft.
 GRAVEL PACK INTERVALS: From **68** ft. to **95** ft., From _____ ft. to _____ ft.
 From _____ ft. to _____ ft., From _____ ft. to _____ ft.

6 GROUT MATERIAL: 1 Neat cement **2** Cement grout **3** Bentonite 4 Other _____
 Grout Intervals: From **0** ft. to **66** ft., From **66** ft. to **68** ft., From _____ ft. to _____ ft.
 What is the nearest source of possible contamination:
 1 Septic tank 4 Lateral lines 7 Pit privy 10 Livestock pens 14 Abandoned water well
 2 Sewer lines 5 Cess pool 8 Sewage lagoon 11 Fuel storage 15 Oil well/Gas well
 3 Watertight sewer lines 6 Seepage pit 9 Feedyard 12 Fertilizer storage **16** Other (specify below)
 3 Watertight sewer lines 6 Seepage pit 9 Feedyard 13 Insecticide storage **Former UST Basin**
 Direction from well? **S** How many feet? **160**

FROM	TO	LITHOLOGIC LOG	FROM	TO	PLUGGING INTERVALS
0	0.33	Asphalt,			
0.33	2	Silt, Gray			
2	8	Silt, Light Brown			
8	18	Silt, Medium Brown			
18	21	Silt, Light Brown			
21	28	Sand, Brown			
28	30	Silt, Tan to Light Yellow Brown			
30	34	Silt, Brown			
34	48	Silt, Light Brown			
48	56	Sand, Brown to Light Tan			
56	63	Silt, Brown			
63	95	Sand, Light Yellow Brown			
					MW3, Tag # 00164874, Flushmount
					Project Name: Travel Shoppe #1
					GeoCore # 211, KDHE # U6 098 850

7 CONTRACTOR'S OR LANDOWNER'S CERTIFICATION: This water well was **(1)** constructed, (2) reconstructed, or (3) plugged under my jurisdiction and was completed on (mo/day/year) **7/9/96** and this record is true to the best of my knowledge and belief.
 Kansas Water Well Contractor's License No. **527** This Water Well Record was completed on (mo/day/yr) **7/22/96**
 under the business name of **GeoCore Services, Inc.** by (signature) *[Signature]*

OFFICE USE ONLY
T
R
E
M
S
E
C