


1 LOCATION OF WATER WELL: County: Trego	Fraction SW ¼ NW ¼ NW ¼	Section Number 16	Township Number T 12 S	Range Number R 23 <u>EW</u>
---	-----------------------------------	-----------------------------	----------------------------------	---------------------------------------

Distance and direction from nearest town or city street address of well if located within city?
I-70 & K-283 - Wakeeney, Kansas

2 WATER WELL OWNER: **The Service Oil Company**
 RR#, St. Address, Box # : **P.O. Box 446**
 City, State, ZIP Code : **Colby, Kansas 67701**
 Board of Agriculture, Division of Water Resources
 Application Number:

3 LOCATE WELL'S LOCATION WITH AN "X" IN SECTION BOX:

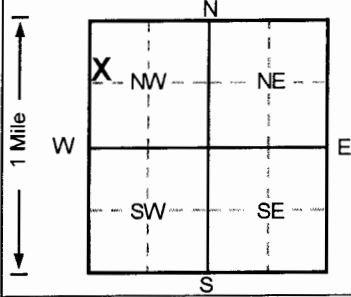

4 DEPTH OF COMPLETED WELL **95** ft. ELEVATION: **2447.54** ft.
 Depth(s) Groundwater Encountered 1. **999** ft. 2. ft. 3. ft.
 WELL'S STATIC WATER LEVEL **82.81** ft. below land surface measured on mo/day/yr **7/11/96**
 Pump test data: Well water was **NA** ft. after hours pumping gpm
 Est. Yield **NA** gpm: Well water was ft. after hours pumping gpm
 Bore Hole Diameter **8** in. to **95** ft., and in. to ft.
 WELL WATER TO BE USED AS: 5 Public water supply 8 Air conditioning 11 Injection well
 1 Domestic 3 Feedlot 6 Oil field water supply 9 Dewatering 12 Other (Specify below)
 2 Irrigation 4 Industrial 7 Lawn and garden only **10** Monitoring well
 Was a chemical/bacteriological sample submitted to Department? Yes.....No ; If yes, mo/day/yr sample was submitted
 Water Well Disinfected? Yes No

5 TYPE OF BLANK CASING USED:
 1 Steel 3 RMP (SR) 5 Wrought iron 8 Concrete tile CASING JOINTS: Glued Clamped
2 PVC 4 ABS 6 Asbestos-Cement 9 Other (specify below) Welded
 7 Fiberglass Threaded.
 Blank casing diameter **2** in. to **70** ft., Dia in. to ft., Dia in. to ft.
 Casing height above land surface **-1.56** in., weight lbs./ft. Wall thickness or gauge No. **Sch. 40**
 TYPE OF SCREEN OR PERFORATION MATERIAL
 1 Steel 3 Stainless steel 5 Fiberglass **7** PVC 10 Asbestos-cement
 2 Brass 4 Galvanized steel 6 Concrete tile 8 RMP (SR) 11 Other (specify)
 9 ABS 12 None used (open hole)
 SCREEN OR PERFORATION OPENINGS ARE:
 1 Continuous slot **3** Mill slot 5 Gauzed wrapped 8 Saw cut 11 None (open hole)
 2 Louvered shutter 4 Key punched 6 Wire wrapped 9 Drilled holes
 7 Torch cut 10 Other (specify)
 SCREEN-PERFORATED INTERVALS: From **70** ft. to **95** ft., From ft. to ft.
 From ft. to ft., From ft. to ft.
 GRAVEL PACK INTERVALS: From **68** ft. to **95** ft., From ft. to ft.
 From ft. to ft., From ft. to ft.

6 GROUT MATERIAL: 1 Neat cement **2** Cement grout **3** Bentonite 4 Other
 Grout Intervals: From **0** ft. to **66** ft., From **66** ft. to **68** ft., From ft. to ft.
 What is the nearest source of possible contamination:
 1 Septic tank 4 Lateral lines 7 Pit privy 10 Livestock pens 14 Abandoned water well
 2 Sewer lines 5 Cess pool 8 Sewage lagoon 11 Fuel storage 15 Oil well/Gas well
 3 Watertight sewer lines 6 Seepage pit 9 Feedyard 12 Fertilizer storage **16** Other (specify below)
 **Former UST Basin**
 Direction from well? **NW** How many feet? **220**

FROM	TO	LITHOLOGIC LOG	FROM	TO	PLUGGING INTERVALS
0	0.33	Asphalt,			
0.33	2	Clay, Dark Brown			
2	8	Silt, Light Brown			
8	12	Silt, Medium Brown			
12	21.5	Silt, Tan			
21.5	23	Sand, Light Brown			
23	26	Sand, Light Brown			
26	49	Silt, Light Yellow Brown to Tan			
49	59	Sand, Brown			
59	73	Sand, Light Brown to Light Gray Brown			
73	95	Sand, Light Yellow Gray			
					MW4, Tag # 00164928, Flushmount
					Project Name: Travel Shoppe #1
					GeoCore # 211, KDHE # U6 098 850

7 CONTRACTOR'S OR LANDOWNER'S CERTIFICATION: This water well was **(1)** constructed, (2) reconstructed, or (3) plugged under my jurisdiction and was completed on (mo/day/year) **7/9/96** and this record is true to the best of my knowledge and belief.
 Kansas Water Well Contractor's License No. **527** This Water Well Record was completed on (mo/day/yr) **7/22/96**
 under the business name of **GeoCore Services, Inc.** by (signature) *Dale A. Bell*

INSTRUCTIONS: Use typewriter or ball point pen. PLEASE PRESS FIRMLY and PRINT clearly. Please fill in blanks, underline or circle the correct answers. Send top three copies to Kansas Department of Health and Environment, Bureau of Water, Topeka, Kansas 66620-0001. Telephone: 913-296-5545. Send one to WATER WELL OWNER and retain one for your records.

OFFICE USE ONLY
T
R
EW
SEC