


1] LOCATION OF WATER WELL: County: Trego	Fraction SW ¼ NW ¼ NW ¼	Section Number 16	Township Number T 12 S	Range Number R 23 EW
--	-----------------------------------	-----------------------------	----------------------------------	---------------------------------------

Distance and direction from nearest town or city street address of well if located within city?
I-70 & K-283 - Wakeeney, Kansas

2] WATER WELL OWNER: **The Service Oil Company**
 RR#, St. Address, Box # : **P.O. Box 446**
 City, State, ZIP Code : **Colby, Kansas 67701**
 Board of Agriculture, Division of Water Resources
 Application Number:

3] LOCATE WELL'S LOCATION WITH AN "X" IN SECTION BOX:

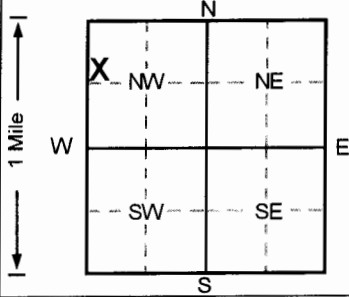

4] DEPTH OF COMPLETED WELL **95** ft. ELEVATION: **2446.57** ft.
 Depth(s) Groundwater Encountered 1. **999** ft. 2. ft. 3. ft.
 WELL'S STATIC WATER LEVEL . . . **80.43** . . . ft. below land surface measured on mo/day/yr . . . **7/11/96** . . .

Pump test data: Well water was . . . **NA** . . . ft. after hours pumping gpm
 Est. Yield . . **NA** . . . gpm; Well water was ft. after hours pumping gpm
 Bore Hole Diameter . . . **8** . . . in. to **95** ft., and in. to ft.
 WELL WATER TO BE USED AS: 5 Public water supply 8 Air conditioning 11 Injection well
 1 Domestic 3 Feedlot 6 Oil field water supply 9 Dewatering 12 Other (Specify below)
 2 Irrigation 4 Industrial 7 Lawn and garden only **10** Monitoring well
 Was a chemical/bacteriological sample submitted to Department? Yes.....No ; If yes, mo/day/yr sample was submitted
 Water Well Disinfected? Yes No

5] TYPE OF BLANK CASING USED:

1 Steel	3 RMP (SR)	5 Wrought iron	8 Concrete tile	CASING JOINTS: Glued Clamped
2 PVC	4 ABS	6 Asbestos-Cement	9 Other (specify below)	Welded
		7 Fiberglass		Threaded. <input checked="" type="checkbox"/>

Blank casing diameter **2** in. to **70** ft., Dia in. to ft., Dia in. to ft.
 Casing height above land surface **-1.68** in., weight lbs./ft. Wall thickness or gauge No. **Sch. 40**

TYPE OF SCREEN OR PERFORATION MATERIAL

1 Steel	3 Stainless steel	5 Fiberglass	7 PVC	10 Asbestos-cement
2 Brass	4 Galvanized steel	6 Concrete tile	8 RMP (SR)	11 Other (specify)
			9 ABS	12 None used (open hole)

SCREEN OR PERFORATION OPENINGS ARE:

1 Continuous slot	3 Mill slot	5 Gauzed wrapped	8 Saw cut	11 None (open hole)
2 Louvered shutter	4 Key punched	6 Wire wrapped	9 Drilled holes	
		7 Torch cut	10 Other (specify)	

SCREEN-PERFORATED INTERVALS: From **70** ft. to **95** ft., From ft. to ft.
 From ft. to ft., From ft. to ft.
 GRAVEL PACK INTERVALS: From **67.5** ft. to **95** ft., From ft. to ft.
 From ft. to ft., From ft. to ft.

6] GROUT MATERIAL: 1 Neat cement **2** Cement grout **3** Bentonite 4 Other
 Grout Intervals: From **0** ft. to **65.5** ft., From **65.5** ft. to **67.5** ft., From ft. to ft.

What is the nearest source of possible contamination:
 1 Septic tank 4 Lateral lines 7 Pit privy 10 Livestock pens 14 Abandoned water well
 2 Sewer lines 5 Cess pool 8 Sewage lagoon 11 Fuel storage 15 Oil well/Gas well
 3 Watertight sewer lines 6 Seepage pit 9 Feedyard 12 Fertilizer storage **16** Other (specify below)
Former UST Basin
 Direction from well? **SE** How many feet? **140**

FROM	TO	LITHOLOGIC LOG	FROM	TO	PLUGGING INTERVALS
0	0.5	Cement,			
0.5	7	Sand, Brown			
7	17	Silt, Light Brown			
17	28	Silt, Medium Brown			
28	37	Silt, Brown			
37	43	Sand, Tan to Light Brown			
43	73	Sand, Light Brown			
73	95	Sand, Light Green Tan to Tan			
					MW7 , Tag # 00164881 , Flushmount
					Project Name: Travel Shoppe #1
					GeoCore # 211 , KDHE # U6 098 850

7] CONTRACTOR'S OR LANDOWNER'S CERTIFICATION: This water well was **1** constructed, **2** reconstructed, or **3** plugged under my jurisdiction and was completed on (mo/day/year) **7/9/96** and this record is true to the best of my knowledge and belief.
 Kansas Water Well Contractor's License No. **527** This Water Well Record was completed on (mo/day/yr) **7/22/96**
 under the business name of **GeoCore Services, Inc.** by (signature) *Joe A. Holt*

OFFICE USE ONLY

T

R

EW

SEC

1/4

1/4

1/4