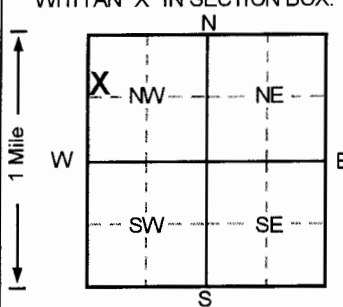


1 LOCATION OF WATER WELL: County: **Trego** Fraction: **SW ¼ NW ¼ NW ¼** Section Number: **16** Township Number: **T 12 S** Range Number: **R 23 E** **W**

Distance and direction from nearest town or city street address of well if located within city?
I-70 & K-283 - Wakeeney, Kansas

2 WATER WELL OWNER: **The Service Oil Company**
 RR#, St. Address, Box # : **P.O. Box 446** Board of Agriculture, Division of Water Resources
 City, State, ZIP Code : **Colby, Kansas 67701** Application Number:

3 LOCATE WELL'S LOCATION WITH AN "X" IN SECTION BOX:


4 DEPTH OF COMPLETED WELL: **95** ft. ELEVATION: **2447.79**
 Depth(s) Groundwater Encountered 1. **999** ft. 2. ft. 3. ft.
 WELL'S STATIC WATER LEVEL: **82.65** ft. below land surface measured on mo/day/yr **7/11/96**
 Pump test data: Well water was **NA** ft. after hours pumping gpm
 Est. Yield **NA** gpm: Well water was ft. after hours pumping gpm
 Bore Hole Diameter **8** in. to **95** in. to ft.
 WELL WATER TO BE USED AS: 5 Public water supply 8 Air conditioning 11 Injection well
 1 Domestic 3 Feedlot 6 Oil field water supply 9 Dewatering 12 Other (Specify below)
 2 Irrigation 4 Industrial 7 Lawn and garden only **10** Monitoring well
 Was a chemical/bacteriological sample submitted to Department? Yes.....No ; If yes, mo/day/yr sample was submitted
 Water Well Disinfected? Yes No

5 TYPE OF BLANK CASING USED:
 1 Steel 3 RMP (SR) 5 Wrought iron 8 Concrete tile CASING JOINTS: Glued Clamped
2 PVC 4 ABS 6 Asbestos-Cement 9 Other (specify below) Welded
 7 Fiberglass Threaded
 Blank casing diameter **2** in. to **70** ft., Dia. in. to ft., Dia. in. to ft.
 Casing height above land surface **-1.2** in., weight lbs./ft. Wall thickness or gauge No. **Sch. 40**
 TYPE OF SCREEN OR PERFORATION MATERIAL: **7** PVC 10 Asbestos-cement
 1 Steel 3 Stainless steel 5 Fiberglass 8 RMP (SR) 11 Other (specify)
 2 Brass 4 Galvanized steel 6 Concrete tile 9 ABS 12 None used (open hole)
 SCREEN OR PERFORATION OPENINGS ARE:
 1 Continuous slot **3** Mill slot 5 Gauzed wrapped 8 Saw cut 11 None (open hole)
 2 Louvered shutter 4 Key punched 6 Wire wrapped 9 Drilled holes
 7 Torch cut 10 Other (specify)
 SCREEN-PERFORATED INTERVALS: From **70** ft. to **95** ft., From ft. to ft.
 From ft. to ft., From ft. to ft.
 GRAVEL PACK INTERVALS: From **67.5** ft. to **95** ft., From ft. to ft.
 From ft. to ft., From ft. to ft.

6 GROUT MATERIAL: 1 Neat cement **2** Cement grout **3** Bentonite 4 Other
 Grout Intervals: From **0** ft. to **65.5** ft., From **65.5** ft. to **67.5** ft., From ft. to ft.
 What is the nearest source of possible contamination:
 1 Septic tank 4 Lateral lines 7 Pit privy 10 Livestock pens 14 Abandoned water well
 2 Sewer lines 5 Cess pool 8 Sewage lagoon 11 Fuel storage 15 Oil well/Gas well
 3 Watertight sewer lines 6 Seepage pit 9 Feedyard 12 Fertilizer storage **16** Other (specify below)
 13 Insecticide storage **Former UST Basin**
 Direction from well? **NW** How many feet? **110**

FROM	TO	LITHOLOGIC LOG	FROM	TO	PLUGGING INTERVALS
0	0.33	Asphalt,			
0.33	2	Clay, Dark Brown			
2	8	Silt, Light Brown			
8	13	Silt, Medium Brown			
13	22	Silt, Tan			
22	28	Sand, Brown			
28	49	Silt, Light Brown			
49	60	Sand, Brown			
60	95	Sand, Light Brown to Light Gray Brown			
					MW9, Tag # 00164935, Flushmount
					Project Name: Travel Shoppe #1
					GeoCore # 211, KDHE # U6 098 850

7 CONTRACTOR'S OR LANDOWNER'S CERTIFICATION: This water well was **(1)** constructed, (2) reconstructed, or (3) plugged under my jurisdiction and was completed on (mo/day/year) **7/9/96** and this record is true to the best of my knowledge and belief.
 Kansas Water Well Contractor's License No. **527** This Water Well Record was completed on (mo/day/yr) **7/22/96**
 under the business name of **GeoCore Services, Inc.** by (signature) *Dale A. Roll*

OFFICE USE ONLY
T
R
E
W
S
E
C