


1 LOCATION OF WATER WELL: County: Trego Fraction SW 1/4 NW 1/4 NW 1/4 Section Number 15 Township Number T 12 S Range Number R 23 EW

Distance and direction from nearest town or city street address of well if located within city? 910 S. 13th, Wakeeney, Kansas

2 WATER WELL OWNER: Quality Mart, Inc. RR#, St Address, Box #: 910 S. 13th Board of Agriculture, Division of Water Resources City, State, ZIP Code: Wakeeney, Kansas 67672 Application Number:

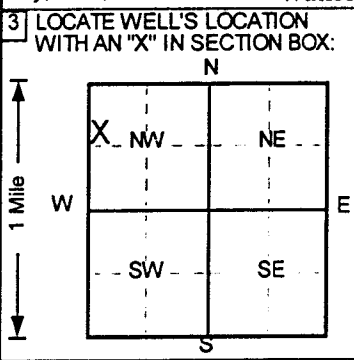

3 LOCATE WELL'S LOCATION WITH AN 'X' IN SECTION BOX: 4 DEPTH OF COMPLETED WELL: 95 ft ELEVATION: 2438.7 Depth(s) Groundwater Encountered 1: .999 ft 2: ft 3: ft WELL'S STATIC WATER LEVEL: 78.41 ft below land surface measured on mo/day/yr 8/1/97 Pump test data: Well water was NA ft after hours pumping gpm Est Yield NA gpm Well water was ft after hours pumping gpm Bore Hole Diameter 8 in. to .95 ft, and in. to ft WELL WATER TO BE USED AS: 5 Public water supply 8 Air conditioning 11 Injection well 1 Domestic 3 Feedlot 6 Oil field water supply 9 Dewatering 12 Other (Specify below) 2 Irrigation 4 Industrial 7 Lawn and garden only 10 Monitoring well Was a chemical/bacteriological sample submitted to Department? Yes No If yes, mo/day/yr sample was submitted Water Well Disinfected? Yes No

5 TYPE OF BLANK CASING USED: 1 Steel 3 RMP (SR) 5 Wrought iron 8 Concrete tile CASING JOINTS: Glued Clamped 2 PVC 4 ABS 6 Asbestos-Cement 9 Other (specify below) Welded Threaded

Blank casing diameter: .2 in. to .70 ft, Dia in. to ft, Dia in. to ft Casing height above land surface: -6.12 in., weight Sch 40 lbs./ft Wall thickness or gauge No.

TYPE OF SCREEN OR PERFORATION MATERIAL: 1 Steel 3 Stainless steel 5 Fiberglass 7 PVC 10 Asbestos-cement 2 Brass 4 Galvanized steel 6 Concrete tile 8 RMP (SR) 11 Other (specify) 12 None used (open hole)

SCREEN OR PERFORATION OPENINGS ARE: 1 Continuous slot 3 Mill slot 5 Gauzed wrapped 8 Saw cut 11 None (open hole) 2 Louvered shutter 4 Key punched 6 Wire wrapped 9 Drilled holes 10 Other (specify)

SCREEN-PERFORATED INTERVALS: From 70 ft to 95 ft, From ft to ft, From ft to ft GRAVEL PACK INTERVALS: From 68 ft to 95 ft, From ft to ft, From ft to ft

6 GROUT MATERIAL: 1 Neat cement 2 Cement grout 3 Bentonite 4 Other Grout Intervals: From 0 ft to 66 ft, From 66 ft to 68 ft, From ft to ft

What is the nearest source of possible contamination: 1 Septic tank 4 Lateral lines 7 Pit privy 10 Livestock pens 14 Abandoned water well 2 Sewer lines 5 Cess pool 8 Sewage lagoon 11 Fuel storage 15 Oil well/Gas well 3 Watertight sewer lines 6 Seepage pit 9 Feedyard 12 Fertilizer storage 16 Other (specify below) Former UST Basin Direction from well? West How many feet? 0

Table with columns: FROM, TO, LITHOLOGIC LOG, FROM, TO, PLUGGING INTERVALS. Rows include: 0-1 Gravel, 1-15 Clay, Dark Brown, 15-18 Clay, Red Brown, 18-24 Sand, Light Brown, 24-32 Sand, Light Red Brown, 32-52 Sand, Light Brown, 52-95 Sand, Light Green. Additional info: MW2, Tag # 00159087, Flushmount; Project Name: Quality Mart, Inc; GeoCore # 489, KDHE # U6 098 790

7 CONTRACTOR'S OR LANDOWNER'S CERTIFICATION: This water well was (1) constructed, (2) reconstructed, or (3) plugged under my jurisdiction and was completed on (mo/day/year) 7/8/97 and this record is true to the best of my knowledge and belief. Kansas Water Well Contractor's License No. 527 This Water Well Record was completed on (mo/day/yr) 9/2/97 under the business name of GeoCore Services, Inc. by (signature)

OFFICE USE ONLY T R EW SEC. 1/4 1/4