


1 LOCATION OF WATER WELL: Fraction Section Number Township Number Range Number
County: Trego NE 1/4 SE 1/4 NE 1/4 16 T 12 S R 23 E/W

Distance and direction from nearest town or city street address of well if located within city?

I-70 & K-283 - Wakeeney, Kansas

2 WATER WELL OWNER: The Service Oil Company
RR#, St. Address, Box #: P.O. Box 446
City, State, ZIP Code: Colby, Kansas 67701
Board of Agriculture, Division of Water Resources
Application Number:

3 LOCATE WELL'S LOCATION WITH AN "X" IN SECTION BOX:

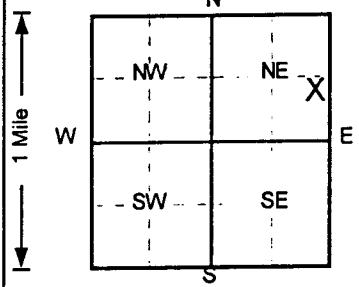

4 DEPTH OF COMPLETED WELL: 97 ft. ELEVATION: 2446.31
Depth(s) Groundwater Encountered 1: 999 ft 2: ft 3: ft
WELL'S STATIC WATER LEVEL: 82.56 ft below land surface measured on mo/day/yr 7/11/97
Pump test data: Well water was NA ft after ... hours pumping ... gpm
Est. Yield NA gpm: Well water was ... ft after ... hours pumping ... gpm
Bore Hole Diameter 8 in. to 97 ft, and ... in. to ... ft
WELL WATER TO BE USED AS: 5 Public water supply 8 Air conditioning 11 Injection well
1 Domestic 3 Feedlot 6 Oil field water supply 9 Dewatering 12 Other (Specify below)
2 Irrigation 4 Industrial 7 Lawn and garden only 10 Monitoring well
Was a chemical/bacteriological sample submitted to Department? Yes No [checked] If yes, mo/day/yr sample was submitted
Water Well Disinfected? Yes No [checked]

5 TYPE OF BLANK CASING USED: 1 Steel 2 PVC [checked] 3 RMP (SR) 4 ABS
5 Wrought iron 6 Asbestos-Cement 7 Fiberglass
8 Concrete tile 9 Other (specify below)
CASING JOINTS: Glued Clamped Welded Threaded [checked]

Blank casing diameter 2 in. to 72 ft, Dia ... in. to ... ft, Dia ... in. to ... ft
Casing height above land surface -4.2 in., weight Sch 40 lbs./ft. Wall thickness or gauge No.

TYPE OF SCREEN OR PERFORATION MATERIAL: 1 Steel 2 Brass 3 Stainless steel 4 Galvanized steel 5 Fiberglass 6 Concrete tile 7 PVC [checked] 8 RMP (SR) 9 ABS 10 Asbestos-cement 11 Other (specify) 12 None used (open hole)

SCREEN OR PERFORATION OPENINGS ARE: 1 Continuous slot 2 Louvered shutter 3 Mill slot [checked] 4 Key punched 5 Gauzed wrapped 6 Wire wrapped 7 Torch cut 8 Saw cut 9 Drilled holes 10 Other (specify) 11 None (open hole)

SCREEN-PERFORATED INTERVALS: From 72 ft to 97 ft, From ... ft to ... ft, From ... ft to ... ft

GRAVEL PACK INTERVALS: From 70 ft to 97 ft, From ... ft to ... ft, From ... ft to ... ft

6 GROUT MATERIAL: 1 Neat cement 2 Cement grout [checked] 3 Bentonite 4 Other
Grout intervals: From 0 ft to 68 ft, From 68 ft to 70 ft, From ... ft to ... ft

What is the nearest source of possible contamination: 1 Septic tank 2 Sewer lines 3 Watertight sewer lines 4 Lateral lines 5 Cess pool 6 Seepage pit 7 Pit privy 8 Sewage lagoon 9 Feedyard 10 Livestock pens 11 Fuel storage 12 Fertilizer storage 13 Insecticide storage 14 Abandoned water well 15 Oil well/Gas well 16 Other (specify below) [checked] Former UST Basin

Table with columns: FROM, TO, LITHOLOGIC LOG, FROM, TO, PLUGGING INTERVALS. Rows include lithology descriptions like Clay, Dark Brown, Sand, Multi, Clay, Tan, Sand, Light Brown.

7 CONTRACTOR'S OR LANDOWNER'S CERTIFICATION: This water well was (1) constructed, (2) reconstructed, or (3) plugged under my jurisdiction and was completed on (mo/day/year) 6/9/97 and this record is true to the best of my knowledge and belief.
Kansas Water Well Contractor's License No. 527 This Water Well Record was completed on (mo/day/yr) 7/14/97
under the business name of GeoCore Services, Inc. by (signature) Dale a Robl

INSTRUCTIONS: Use typewriter or ball point pen. PLEASE PRESS FIRMLY and PRINT clearly. Please fill in blanks, underline or circle the correct answers. Send top three copies to Kansas Department of Health and Environment, Bureau of Water, Topeka, Kansas 66820-0001. Telephone: 913-296-5545. Send one to WATER WELL OWNER and retain one for your records.