


1 LOCATION OF WATER WELL: County: Trego Fraction: NW 1/4 NW 1/4 SE 1/4 Section Number: 9 Township Number: T 12 S Range Number: R 23 EW

Distance and direction from nearest town or city street address of well if located within city?  
704 Barclay Ave.

2 WATER WELL OWNER: Sprint Mart RR#, St. Address, Box #: 67656 City, State, ZIP Code: 704 Barclay Wabearney, KS Board of Agriculture, Division of Water Resources Application Number: MWZ

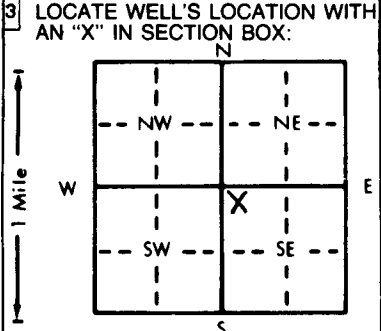

4 DEPTH OF COMPLETED WELL: 80' ft. ELEVATION: 2443.89  
 Depth(s) Groundwater Encountered 1. 65-70 ft. 2. 65-64 ft. 3.          ft.  
 WELL'S STATIC WATER LEVEL 65-64 ft. below land surface measured on mo/day/yr 12/16/98  
 Pump test data: Well water was          ft. after          hours pumping          gpm  
 Est. Yield          gpm; Well water was          ft. after          hours pumping          gpm  
 Bore Hole Diameter: 8 in. to 80 ft., and          in. to          ft.  
 WELL WATER TO BE USED AS:  
 1 Domestic 3 Feedlot 6 Oil field water supply 9 Dewatering 12 Other (Specify below)  
 2 Irrigation 4 Industrial 7 Lawn and garden only 10 Monitoring well  
 Was a chemical/bacteriological sample submitted to Department? Yes          No X; If yes, mo/day/yr sample was submitted  
 Water Well Disinfected? Yes          No X

5 TYPE OF BLANK CASING USED:  
 1 Steel 3 RMP (SR) 5 Wrought iron 8 Concrete tile CASING JOINTS: Glued          Clamped           
2 PVC 4 ABS 7 Fiberglass Welded          Threaded X  
 Blank casing diameter 2 in. to 55 ft., Dia          in. to          ft., Dia          in. to          ft.  
 Casing height above land surface Flush in., weight          lbs./ft. Wall thickness or gauge No.           
 TYPE OF SCREEN OR PERFORATION MATERIAL:  
 1 Steel 3 Stainless steel 5 Fiberglass 7 PVC 10 Asbestos-cement  
 2 Brass 4 Galvanized steel 6 Concrete tile 8 RMP (SR) 11 Other (specify)           
 9 ABS 12 None used (open hole)  
 SCREEN OR PERFORATION OPENINGS ARE:  
 1 Continuous slot 3 Mill slot 5 Gauzed wrapped 8 Saw cut 11 None (open hole)  
 2 Louvered shutter 4 Key punched 6 Wire wrapped 9 Drilled holes  
 7 Torch cut 10 Other (specify)           
 SCREEN-PERFORATED INTERVALS: From 80 ft. to 55 ft., From          ft. to          ft.  
 From          ft. to          ft., From          ft. to          ft.  
 GRAVEL PACK INTERVALS: From 80 ft. to 53 ft., From          ft. to          ft.  
 From          ft. to          ft., From          ft. to          ft.

6 GROUT MATERIAL: 1 Neat cement 2 Cement grout 3 Bentonite 4 Other           
 Grout Intervals: From 53 ft. to 1 ft., From          ft. to          ft., From          ft. to          ft.  
 What is the nearest source of possible contamination:  
 1 Septic tank 4 Lateral lines 7 Pit privy 11 Fuel storage 14 Abandoned water well  
 2 Sewer lines 5 Cess pool 8 Sewage lagoon 12 Fertilizer storage 15 Oil well/Gas well  
 3 Watertight sewer lines 6 Seepage pit 9 Feedyard 13 Insecticide storage 16 Other (specify below)           
 Direction from well? North How many feet? 50

FROM	TO	LITHOLOGIC LOG	FROM	TO	PLUGGING INTERVALS
0	15'	Brown loess			
15	30'	" sand			
30	60'	Tan Silty clay			
60	80'	Brown Sand			

7 CONTRACTOR'S OR LANDOWNER'S CERTIFICATION: This water well was (1) constructed, (2) reconstructed, or (3) plugged under my jurisdiction and was completed on (mo/day/year) 12-1998 and this record is true to the best of my knowledge and belief. Kansas Water Well Contractor's License No. 634 This Water Well Record was completed on (mo/day/yr) 1-25-99 under the business name of Shady Env. Today LLC by (signature) Murphy