


1 LOCATION OF WATER WELL: Fraction ^{sw} ~~SE~~ 1/4 SE 1/4 NW 1/4 Section Number 9 Township Number T12S Range Number R23W
 County: Trego

Distance and direction from nearest town or city street address of well if located within city?
510 North Railroad

2 WATER WELL OWNER: Glen Riggs
 RR #, St. Address, Box #: P.O. Box 223 Board of Agriculture, Division of Water Resources
 City, State, ZIP Code: Wakarusa, Kansas 67672 Application Number: _____

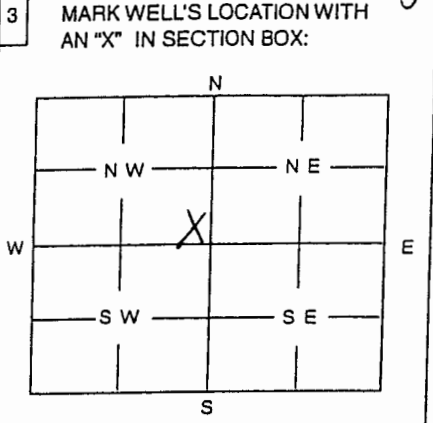

4 DEPTH OF WELL 90.4 ft
 WELL'S STATIC WATER LEVEL 74 ft
 WELL WAS USED AS:
 1 Domestic 2 Irrigation 3 Feedlot 4 Industrial 5 Public Water Supply 6 Oil Field Water Supply 7 Domestic (Lawn & Garden) 8 Air Conditioning 9 Dewatering 10 Monitoring Well 11 Injection Well 12 Other _____
 Was a chemical / bacteriological sample submitted to Department? Yes _____ No
 If yes, mo/day/yr sample was submitted _____
 Water Well Disinfected: Yes _____ No

5 TYPE OF BLANK CASING USED:
 1 Steel 2 PVC 3 RMP (SR) 4 ABS 5 Wrought 6 Asbestos-Cement 7 Fiberglass 8 Concrete Tile 9 Other (Specify below) _____
 Blank casing diameter 4 in. Was casing pulled? Yes _____ No If yes, how much _____
 Casing height above or below land surface 0 in.

6 GROUT PLUG MATERIAL: 1 Neat cement 2 Cement grout 3 Bentonite 4 Other _____
 Grout Plug Intervals: From 0 ft. to 90.4 ft., From _____ ft. to _____ ft., From _____ to _____ ft.
 What is the nearest source of possible contamination:
 1 Septic tank 2 Sewer lines 3 Watertight sewer lines 4 Lateral lines 5 Cess Pool 6 Seepage pit 7 Pit privy 8 Sewage lagoon 9 Feedyard 10 Livestock pens 11 Fuel storage 12 Fertilizer storage 13 Insecticide storage 14 Abandoned water well 15 Oil well/Gas well 16 Other (specify below) _____
 Direction from well? W.N.W. How many feet? 200

FROM	TO	PLUGGING MATERIALS
<u>0</u>	<u>3'</u>	<u>Bentonite (8")</u>
<u>3</u>	<u>90.4'</u>	<u>Bentonite (4")</u>

MW17

7 CONTRACTOR'S OR LANDOWNER'S CERTIFICATION: This water well was plugged under my jurisdiction and was completed on (mo/day/year) 12/22/00 and this record is true to the best of my knowledge and belief. Kansas Water Well Contractor's License No. 527 This Water Well Record was completed on (mo/day/year) 12/28/00 under the business name of Geo Case Services, Inc.
 by (signature) Adel Wolf

INSTRUCTIONS: Use typewriter or ball point pen. Please press firmly and print clearly. Please fill in blanks, underline or circle the correct answers. Send top three copies to Kansas Department of Health and Environment, Bureau of Water, Topeka, Kansas 66620-0001. Telephone: 785/296-3555. Send one to Water Well Owner and retain one for your records.