
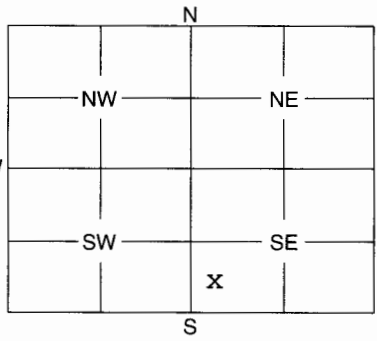


1	LOCATION OF WATER WELL:	Fraction	Section Number	Township Number	Range Number
County: TREGO		SW 1/4 SW 1/4 SE 1/4	2	12	23 W 

Distance and direction from nearest town or city street address of well if located within city?

512 N 9th Wakeeney KS

2	WATER WELL OWNER: ALICE RUDER	
	RR #, St. Address, Box #: 512 N 9th	Board of Agriculture, Division of Water Resources
	City, State, ZIP Code: WAKEENEY KS 67672	Application Number:

3	MARK WELL'S LOCATION WITH AN "X" IN SECTION BOX:	4	DEPTH OF WELL ..... 80 ..... ft.
			WELL'S STATIC WATER LEVEL ..... 60 ..... ft.
			WELL WAS USED AS:
			1 Domestic                      5 Public Water Supply                      9 Dewatering 2 Irrigation                      6 Oil Field Water Supply                      10 Monitoring Well 3 Feedlot <input checked="" type="checkbox"/> Domestic (Lawn & Garden)                      11 Injection Well 4 Industrial                      8 Air Conditioning                      12 Other .....
			Was a chemical / bacteriological sample submitted to Department? Yes ..... No <input checked="" type="checkbox"/> .....
			If yes, mo/day/yr sample was submitted .....
			Water Well Disinfected: Yes ..... No <input checked="" type="checkbox"/> .....

5	TYPE OF BLANK CASING USED:	
	1 Steel                      3 RMP (SR)                      5 Wrought                      7 Fiberglass                      9 Other (Specify below) <input checked="" type="checkbox"/> RVC                      4 ABS                      6 Asbestos-Cement                      8 Concrete Tile	
	Blank casing diameter ..... 5 ..... in.	Was casing pulled? Yes <input checked="" type="checkbox"/> ..... No ..... If yes, how much ..... 40 .....
	Casing height above or below land surface ..... 40 ..... in.	

6	GROUT PLUG MATERIAL:	1 Neat cement                      2 Cement grout                      3 Bentonite <input checked="" type="checkbox"/> Other ..... SAND
	Grout Plug Intervals:	From ..... 80 ..... ft. to ..... 30 ..... ft., From ..... ft. to ..... ft., From ..... to ..... ft.
	What is the nearest source of possible contamination:	
	1 Septic tank                      6 Seepage pit                      11 Fuel storage                      16 Other (specify below) 2 Sewer lines                      7 Pit privy                      12 Fertilizer storage 3 Watertight sewer lines                      8 Sewage lagoon                      13 Insecticide storage 4 Lateral lines                      9 Feedyard                      14 Abandoned water well 5 Cess pool                      10 Livestock pens                      15 Oil well/Gas well	
	Direction from well? .....	How many feet? .....

FROM	TO	PLUGGING MATERIALS
80	30	SAND
30	15	COMPAK DIRT
15	0	BENTONITE

RECEIVED

OCT 01 2004

BUREAU OF WATER

7	CONTRACTOR'S OF LANDOWNER'S CERTIFICATION: This water well was plugged under my jurisdiction and was completed on (mo/day/year) <del>1-1-04</del> 9-1-04 and this record is true to the best of my knowledge and belief. Kansas Water Well Contractor's License No. 444 This Water Well Record was completed on (mo/day/year) 7/13/04 under the business name of ANDY ANDERSON DRILLING by (signature) <i>Andy Anderson</i>	
---	---	--

INSTRUCTIONS: Use typewriter or ball point pen. Please press firmly and print clearly. Please fill in blanks, underline or circle the correct answers. Send top three copies to Kansas Department of Health and Environment, Bureau of Water, Geology Section, 1000 SW Jackson St., Ste. 420, Topeka, Kansas 66612-1367. Telephone: 785/296-5522. Send one to Water Well Owner and retain one for your records.