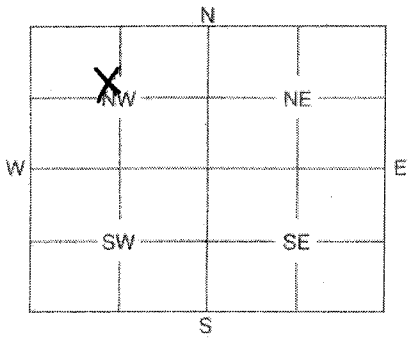


1	LOCATION OF WATER WELL: Trego	Fraction SW $\frac{1}{4}$ NW $\frac{1}{4}$ NW $\frac{1}{4}$	Section Number 16	Township Number 12	Range Number 23	E/W
---	---	--	-----------------------------	------------------------------	---------------------------	-----

Distance and direction from nearest town or city street address of well if located within city?

1-70 and 283 Hwy, Wakeeney, Kansas

2	WATER WELL OWNER: The Service Oil Company	
	RR #, St. Address, Box #: P.O. Box 446	Board of Agriculture, Division of Water Resources
	City, State, ZIP Code: Colby, Kansas	Application Number:

3	MARK WELL'S LOCATION WITH AN "X" IN SECTION BOX: 	4	DEPTH OF WELL 96 ft. WELL'S STATIC WATER LEVEL 77.69 ft. WELL WAS USED AS: <table border="0"> <tr> <td>1 Domestic</td> <td>5 Public Water Supply</td> <td>9 Dewatering</td> </tr> <tr> <td>2 Irrigation</td> <td>6 Oil Field Water Supply</td> <td><input checked="" type="radio"/> 10 Monitoring Well</td> </tr> <tr> <td>3 Feedlot</td> <td>7 Domestic (Lawn & Garden)</td> <td>11 Injection Well</td> </tr> <tr> <td>4 Industrial</td> <td>8 Air Conditioning</td> <td>12 Other</td> </tr> </table>	1 Domestic	5 Public Water Supply	9 Dewatering	2 Irrigation	6 Oil Field Water Supply	<input checked="" type="radio"/> 10 Monitoring Well	3 Feedlot	7 Domestic (Lawn & Garden)	11 Injection Well	4 Industrial	8 Air Conditioning	12 Other

Was a chemical / bacteriological sample submitted to Department? Yes No ☒
If yes, mo/day/yr sample was submitted

Water Well Disinfected: Yes No ☒

5	TYPE OF BLANK CASING USED:	
	<input type="radio"/> 1 Steel <input checked="" type="radio"/> 2 PVC <input type="radio"/> 3 RMP (SR) <input type="radio"/> 4 ABS <input type="radio"/> 5 Wrought <input type="radio"/> 6 Asbestos-Cement <input type="radio"/> 7 Fiberglass <input type="radio"/> 8 Concrete Tile <input type="radio"/> 9 Other (Specify below)	
	Blank casing diameter in.	Was casing pulled? Yes <input checked="" type="checkbox"/> No If yes, how much 3' bgs
	Casing height above or below land surface in.	

6	GROUT PLUG MATERIAL: <input type="radio"/> 1 Neat cement <input type="radio"/> 2 Cement grout <input checked="" type="radio"/> 3 Bentonite <input type="radio"/> 4 Other Surface silts and clays															
	GROUT PLUG INTERVALS: From 96 ft. to 77.69 ft. chl. sand From 77.69 ft. to 3 ft. From 3 ft. to 95 ft.															
	What is the nearest source of possible contamination: <table border="0"> <tr> <td><input type="radio"/> 1 Septic tank</td> <td><input type="radio"/> 6 Seepage pit</td> <td><input type="radio"/> 11 Fuel storage</td> </tr> <tr> <td><input type="radio"/> 2 Sewer lines</td> <td><input type="radio"/> 7 Pit privy</td> <td><input type="radio"/> 12 Fertilizer storage</td> </tr> <tr> <td><input type="radio"/> 3 Watertight sewer lines</td> <td><input type="radio"/> 8 Sewage lagoon</td> <td><input type="radio"/> 13 Insecticide storage</td> </tr> <tr> <td><input type="radio"/> 4 Lateral lines</td> <td><input type="radio"/> 9 Feedyard</td> <td><input type="radio"/> 14 Abandoned water well</td> </tr> <tr> <td><input type="radio"/> 5 Cess pool</td> <td><input type="radio"/> 10 Livestock pens</td> <td><input type="radio"/> 15 Oil well/Gas well</td> </tr> </table>	<input type="radio"/> 1 Septic tank	<input type="radio"/> 6 Seepage pit	<input type="radio"/> 11 Fuel storage	<input type="radio"/> 2 Sewer lines	<input type="radio"/> 7 Pit privy	<input type="radio"/> 12 Fertilizer storage	<input type="radio"/> 3 Watertight sewer lines	<input type="radio"/> 8 Sewage lagoon	<input type="radio"/> 13 Insecticide storage	<input type="radio"/> 4 Lateral lines	<input type="radio"/> 9 Feedyard	<input type="radio"/> 14 Abandoned water well	<input type="radio"/> 5 Cess pool	<input type="radio"/> 10 Livestock pens	<input type="radio"/> 15 Oil well/Gas well
	Direction from well? How many feet?															

FROM	TO	PLUGGING MATERIALS
96	77.69	Chlorinated Sand
77.69	3	Bentonite
3	GS	Surface silts/clays

7	CONTRACTOR'S OF LANDOWNER'S CERTIFICATION: This water well was plugged under my jurisdiction and was completed on (mo/day/year) 02/17/05 and this record is true to the best of my knowledge and belief. Kansas Water Well Contractor's License No. 585 This Water Well Record was completed on (mo/day/year) 03/16/05 under the business name of Associated Environmental, Inc. by (signature) Darin Duncan	
---	--	--

INSTRUCTIONS: Use typewriter or ball point pen. Please press firmly and print clearly. Please fill in blanks, underline or circle the correct answers. Send top three copies to Kansas Department of Health and Environment, Bureau of Water, Geology Section, 1000 SW Jackson St., Ste. 420, Topeka, Kansas 66612-1367. Telephone: 785/296-5522. Send one to Water Well Owner and retain one for your records.