


1 LOCATION OF WATER WELL: Fraction NW 1/4 SW 1/4 NW 1/4 Section Number 16 Township Number T 12 S Range Number R 23 **EMV**  
 County: **Trego**  
 Distance and direction from nearest town or city street address of well if located within city?

**ASSOCIATED - Wakeeney, KS**  
 2 WATER WELL OWNER: Wakeeney Travel Plaza 90 Larry Triplett Inc  
 RR#, St. Address, Box #: PO Box 647 Board of Agriculture, Division of Water Resources  
 City, State, ZIP Code: Salina KS 67402-06 Application Number: **MW-14**

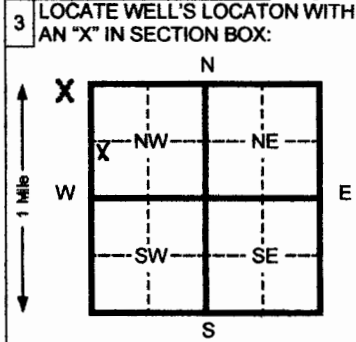

4 DEPTH OF COMPLETED WELL 105 ft. ELEVATION:  
 Depth(s) Groundwater Encountered 1 \_\_\_\_\_ ft. 2 \_\_\_\_\_ ft. 3 \_\_\_\_\_ ft.  
 WELL'S STATIC WATER LEVEL \_\_\_\_\_ ft. below land surface measured on mo/day/yr  
 Pump test data: Well water was \_\_\_\_\_ ft. after \_\_\_\_\_ hours pumping \_\_\_\_\_ gpm  
 Est. Yield \_\_\_\_\_ gpm: Well water was \_\_\_\_\_ ft. after \_\_\_\_\_ hours pumping \_\_\_\_\_ gpm  
 Bore Hole Diameter 8 in. to 105 ft. and \_\_\_\_\_ in. to \_\_\_\_\_ ft.  
 WELL WATER TO BE USED AS: 5 Public water supply 8 Air conditioning 11 Injection well  
 1 Domestic 3 Feed lot 6 Oil field water supply 9 Dewatering 12 Other (Specify below)  
 2 Irrigation 4 Industrial 7 Lawn and garden (domestic) 10 Monitoring well  
 Was a chemical/bacteriological sample submitted to Department? Yes \_\_\_\_\_ No X If yes, mo/day/yr sample was submitted  
 Water Well Disinfected? Yes \_\_\_\_\_ No X

5 TYPE OF BLANK CASING USED:  
 1 Steel 3 RMP (SR) 5 Wrought Iron 8 Concrete tile CASING JOINTS: Glued \_\_\_\_\_ Clamped \_\_\_\_\_  
 2 PVC 4 ABS 6 Asbestos-Cement 9 Other (specify below) Welded \_\_\_\_\_  
 7 Fiberglass Threaded X  
 Blank casing diameter 4 in. to 65 ft., Dia \_\_\_\_\_ in. to \_\_\_\_\_ ft., Dia \_\_\_\_\_ in. to \_\_\_\_\_ ft.  
 Casing height above land surface 0 in., weight 2.071 lbs./ft. Wall thickness or gauge No. .237  
 TYPE OF SCREEN OR PERFORATION MATERIAL:  
 1 Steel 3 Stainless steel 5 Fiberglass 8 RMP (SR) 10 Asbestos-cement  
 2 Brass 4 Galvanized steel 6 Concrete tile 9 ABS 11 Other (specify) \_\_\_\_\_  
 12 None used (open hole)  
 SCREEN OR PERFORATION OPENINGS ARE:  
 1 Continuous slot 3 Mill slot 5 Gauzed wrapped 8 Saw cut 11 None (open hole)  
 2 Louvered shutter 4 Key punched 6 Wire wrapped 9 Drilled holes  
 7 Torch cut 10 Other (specify) \_\_\_\_\_  
 SCREEN-PERFORATED INTERVALS: From 65 ft. to 105 ft. From \_\_\_\_\_ ft. to \_\_\_\_\_ ft.  
 From \_\_\_\_\_ ft. to \_\_\_\_\_ ft. From \_\_\_\_\_ ft. to \_\_\_\_\_ ft.  
 GRAVEL PACK INTERVALS: From 58 ft. to 105 ft. From \_\_\_\_\_ ft. to \_\_\_\_\_ ft.  
 From \_\_\_\_\_ ft. to \_\_\_\_\_ ft. From \_\_\_\_\_ ft. to \_\_\_\_\_ ft.

6 GROUT MATERIAL: 1 Neat cement 2 Cement grout 3 Bentonite 4 Other \_\_\_\_\_  
 Grout intervals From 0 ft. to 58 ft. From \_\_\_\_\_ ft. to \_\_\_\_\_ ft. From \_\_\_\_\_ ft. to \_\_\_\_\_ ft.  
 What is the nearest source of possible contamination:  
 1 Septic tank 4 Lateral lines 7 Pit privy 10 Livestock pens 14 Abandoned water well  
 2 Sewer lines 5 Cess pool 8 Sewage lagoon 11 Fuel storage 15 Oil well/ Gas well  
 3 Watertight sewer lines 6 Seepage pit 9 Feedyard 12 Fertilizer storage 16 Other (specify below)  
**Contaminated site**  
 Direction from well? \_\_\_\_\_ How many feet? \_\_\_\_\_

| FROM | TO  | CODE | LITHOLOGIC LOG                                | FROM | TO | PLUGGING INTERVALS |
|------|-----|------|---|------|----|--------------------|
| 0    | 2   |      | Surface                                       |      |    |                    |
| 2    | 9   |      | Loess   |      |    |                    |
| 9    | 16  |      | Clay w/caliche strks                          |      |    |                    |
| 16   | 24  |      | Fine to med sand w/clay & Caliche             |      |    |                    |
| 24   | 43  |      | Caliche & clay w/traces of sd                 |      |    |                    |
| 43   | 58  |      | Fine to med sd & small gravel w/caliche strks |      |    |                    |
| 58   | 64  |      | Fine to med sd w/caliche lenses               |      |    |                    |
| 64   | 71  |      | Caliche                                       |      |    |                    |
| 71   | 77  |      | Fine to med sd w/caliche strks                |      |    |                    |
| 77   | 87  |      | Fine sand & some med w/ Caliche lenses        |      |    |                    |
| 87   | 105 |      | Fine sand w/caliche lenses                    |      |    |                    |

7 CONTRACTOR'S OR LANDOWNER'S CERTIFICATION: This water well was (1) constructed, (2) reconstructed, or (3) plugged under my jurisdiction and was completed on (mo/day/yr) 10-30-07 and this record is true to the best of my knowledge and belief. Kansas Water Well Contractor's License No. 554 This Water Well Record was completed on (mo/day/yr) 12-07-07 under the business name of Woofor Pump & Well Inc. by signature [Signature]

OFFICE USE ONLY

T

R

SEC