


1	LOCATION OF WATER WELL:	Fraction	Section Number	Township Number	Range Number
County:	<u>Trego</u>	<u>1/4 NE 1/4 NE 1/4</u>	<u>17</u>	<u>12 S</u>	<u>23 W</u>

Distance and direction from nearest town or city street address of well if located within city?
I-70 + 283 Hwy Wakeeney, KS

2	WATER WELL OWNER: <u>Wakeeney Travel Plaza</u>	Board of Agriculture, Division of Water Resources
RR #, St. Address, Box #:	<u>Box 647 Selma KS 67402</u>	Application Number:

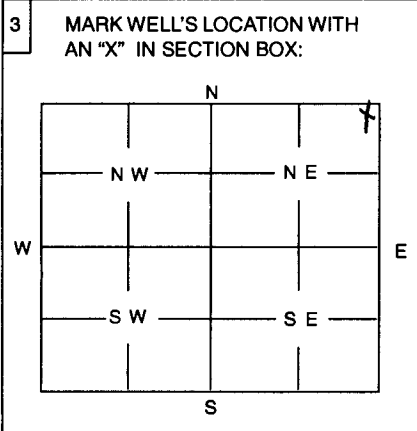

4	DEPTH OF WELL <u>95'</u> ft												
	WELL'S STATIC WATER LEVEL <u>78'</u> ft.												
	WELL WAS USED AS:												
	<table border="0"> <tr> <td>1 Domestic</td> <td>5 Public Water Supply</td> <td>9 Dewatering</td> </tr> <tr> <td>2 Irrigation</td> <td>6 Oil Field Water Supply</td> <td><u>10</u> Monitoring Well</td> </tr> <tr> <td>3 Feedlot</td> <td>7 Domestic (Lawn & Garden)</td> <td>11 Injection Well</td> </tr> <tr> <td>4 Industrial</td> <td>8 Air Conditioning</td> <td>12 Other</td> </tr>
	Was a chemical / bacteriological sample submitted to Department? Yes No <input checked="" type="checkbox"/>												
	If yes, mo/day/yr sample was submitted												
	Water Well Disinfected: Yes No <input checked="" type="checkbox"/>												

5 TYPE OF BLANK CASING USED:

1 Steel	3 RMP (SR)	5 Wrought	7 Fiberglass	9 Other (Specify below)
<u>2 PVC</u>	4 ABS	6 Asbestos-Cement	8 Concrete Tile	

Blank casing diameter 2" in. Was casing pulled? Yes No If yes, how much 3'

Casing height above or below land surface in.

6 GROUT PLUG MATERIAL: 1 Neat cement 2 Cement grout 3 Bentonite 4 Other

Grout Plug Intervals: From 55' ft. to 3' ft., From ft. to ft., From to ft.

What is the nearest source of possible contamination:

1 Septic tank	6 Seepage pit	<u>11 Fuel storage</u>	16 Other (specify below)
2 Sewer lines	7 Pit privy	12 Fertilizer storage	
3 Watertight sewer lines	8 Sewage lagoon	13 Insecticide storage	
4 Lateral lines	9 Feedyard	14 Abandoned water well	
5 Cess Pool	10 Livestock pens	15 Oil well/Gas well	

Direction from well? How many feet?

FROM	TO	PLUGGING MATERIALS
<u>95'</u>	<u>55'</u>	<u>Soil</u>
<u>55'</u>	<u>3'</u>	<u>Bentonite hole plug</u>

* Monitor well vault was damaged + casing was blocked at 55' prompting the plugging of the well. Casing cut off ~3' below grade after being filled with bentonite chips.

7 CONTRACTOR'S OR LANDOWNER'S CERTIFICATION: This water well was plugged under my jurisdiction and was completed on (mo/day/year) 7/11/14 and this record is true to the best of my knowledge and belief. Kansas Water Well Contractor's License No. 77114 Under the business name of KDNE This Water Well Record was completed on (mo/day/year) 7/11/14 by (signature) [Signature]

INSTRUCTIONS: Use typewriter or ballpoint pen. Please press firmly and print clearly. Please fill in blanks, underline or circle the correct answers. Send top three copies to Kansas Department of Health and Environment, Bureau of Water, Topeka, Kansas 66620-0001. Telephone: 785/296-3565. Send one to Water Well Owner and retain one for your records.