

**WATER WELL RECORD Form WWC-5**

Original Record  Correction  Change in Well Use

Division of Water Resources App. No.

Well ID MW-19

<b>1 LOCATION OF WATER WELL:</b> County: <b>Trego</b>	Fraction NW ¼ SE ¼ NE ¼ NE ¼	Section Number <b>17</b>	Township Number <b>T 12 S</b>	Range Number <b>R 23</b> <input type="checkbox"/> E <input checked="" type="checkbox"/> W
--	---------------------------------	-----------------------------	----------------------------------	--

<b>2 WELL OWNER: Last Name:</b> <b>Triplett, Inc.</b> Business: <b>Triplett, Inc.</b> Address: <b>P.O. Box 647</b> Address: City: <b>Salina</b> State: <b>KS</b> ZIP: <b>67402</b>	<b>Street or Rural Address where well is located</b> (if unknown, distance and direction from nearest town or intersection): If at owner's address, check here: <input type="checkbox"/> <b>I-70 &amp; Hwy 283; Wakeeney, KS</b>
--	---

<b>3 LOCATE WELL WITH "X" IN SECTION BOX:</b> N <table border="1" style="width: 100%; text-align: center; border-collapse: collapse;"> <tr> <td style="width: 25%;">NW</td> <td style="width: 25%;">NE</td> <td style="width: 25%;">X</td> <td style="width: 25%;"></td> </tr> <tr> <td>W</td> <td></td> <td></td> <td>E</td> </tr> <tr> <td>SW</td> <td>SE</td> <td></td> <td></td> </tr> <tr> <td colspan="4" style="text-align: center;">S</td> </tr> </table> 1 mile	NW	NE	X		W			E	SW	SE			S				<b>4 DEPTH OF COMPLETED WELL:</b> ... <b>88.00</b> ... ft. Depth(s) Groundwater Encountered: 1) ..... ft. 2) ..... ft. 3) ..... ft., or 4) <input type="checkbox"/> Dry Well <b>WELL'S STATIC WATER LEVEL:</b> ..... <b>70.27</b> ..... ft. <input checked="" type="checkbox"/> below land surface, measured on (mo-day-yr) <b>10-9-18</b> ..... <input type="checkbox"/> above land surface, measured on (mo-day-yr)..... Pump test data: Well water was ..... ft. after ..... hours pumping ..... gpm Well water was ..... ft. after ..... hours pumping ..... gpm Estimated Yield: ..... gpm Bore Hole Diameter: <b>8.5</b> in. to <b>88</b> ft. and <b>6</b> in. to <b>95</b> ft.	<b>5 Latitude:</b> ..... <b>39.01647</b> ..... (decimal degrees) <b>Longitude:</b> ..... <b>99.89186</b> ..... (decimal degrees) Horizontal Datum: <input type="checkbox"/> WGS 84 <input checked="" type="checkbox"/> NAD 83 <input type="checkbox"/> NAD 27 Source for Latitude/Longitude: <input checked="" type="checkbox"/> GPS (unit make/model: .....) (WAAS enabled? <input type="checkbox"/> Yes <input checked="" type="checkbox"/> No) <input type="checkbox"/> Land Survey <input type="checkbox"/> Topographic Map <input type="checkbox"/> Online Mapper: ..... <b>6 Elevation:</b> <b>2438.51</b> ..... ft. <input type="checkbox"/> Ground Level <input checked="" type="checkbox"/> TOC Source: <input checked="" type="checkbox"/> Land Survey <input type="checkbox"/> GPS <input type="checkbox"/> Topographic Map <input type="checkbox"/> Other .....
NW	NE	X																
W			E															
SW	SE																	
S																		

**7 WELL WATER TO BE USED AS:**

1. Domestic: <input type="checkbox"/> Household <input type="checkbox"/> Lawn & Garden <input type="checkbox"/> Livestock 2. Irrigation <input type="checkbox"/> Feedlot <input type="checkbox"/> Industrial	5. <input type="checkbox"/> Public Water Supply: well ID ..... 6. <input type="checkbox"/> Dewatering: how many wells? ..... 7. <input type="checkbox"/> Aquifer Recharge: well ID ..... 8. <input checked="" type="checkbox"/> Monitoring: well ID <b>MW-19</b> ..... 9. Environmental Remediation: well ID ..... <input type="checkbox"/> Air Sparge <input type="checkbox"/> Soil Vapor Extraction <input type="checkbox"/> Recovery <input type="checkbox"/> Injection	10. <input type="checkbox"/> Oil Field Water Supply: lease ..... 11. Test Hole: well ID ..... <input type="checkbox"/> Cased <input type="checkbox"/> Uncased <input type="checkbox"/> Geotechnical 12. Geothermal: how many bores? ..... a) Closed Loop <input type="checkbox"/> Horizontal <input type="checkbox"/> Vertical b) Open Loop <input type="checkbox"/> Surface Discharge <input type="checkbox"/> Inj. of Water 13. <input type="checkbox"/> Other (specify): .....
--	--	---

Was a chemical/bacteriological sample submitted to KDHE?  Yes  No If yes, date sample was submitted: .....  
 Water well disinfected?  Yes  No

**8 TYPE OF CASING USED:**  Steel  PVC  Other ..... CASING JOINTS:  Glued  Clamped  Welded  Threaded  
 Casing diameter ..... **4** ..... in. to ..... **63** ..... ft., Diameter ..... in. to ..... ft., Diameter ..... in. to ..... ft.  
 Casing height above land surface ..... **9** ..... in. Weight ..... lbs./ft. Wall thickness or gauge No. ....  
**TYPE OF SCREEN OR PERFORATION MATERIAL:**  
 Steel  Stainless Steel  Fiberglass  PVC  Other (Specify) .....  
 Brass  Galvanized Steel  Concrete tile  None used (open hole)  
**SCREEN OR PERFORATION OPENINGS ARE:**  
 Continuous Slot  Mill Slot  Gauze Wrapped  Torch Cut  Drilled Holes  Other (Specify) .....  
 Louvered Shutter  Key Punched  Wire Wrapped  Saw Cut  None (Open Hole)  
**SCREEN-PERFORATED INTERVALS:** From **63** ft. to **88** ft., From ..... ft. to ..... ft., From ..... ft. to ..... ft.  
**GRAVEL PACK INTERVALS:** From **60** ft. to **88** ft., From ..... ft. to ..... ft., From ..... ft. to ..... ft.

**9 GROUT MATERIAL:**  Neat cement  Cement grout  Bentonite  Other .....  
 Grout intervals: From **0.5** ft. to **60** ft., From ..... ft. to ..... ft., From ..... ft. to ..... ft.  
**Nearest source of possible contamination:**  
 Septic Tank  Lateral Lines  Pit Privy  Livestock Pens  Insecticide Storage  
 Sewer Lines  Cess Pool  Sewage Lagoon  Fuel Storage  Abandoned Water Well  
 Watertight Sewer Lines  Seepage Pit  Feedyard  Fertilizer Storage  Oil Well/Gas Well  
 Other (Specify) .....  
 Direction from well? ..... Distance from well? ..... ft.

10 FROM	TO	LITHOLOGIC LOG	FROM	TO	LITHO. LOG (cont.) or PLUGGING INTERVALS
0	0.5	Grass			
0.5	13	Silty clay with trace sand			
13	34	Sandy clay and caliche with sand			
34	42	Gravelly sand with caliche and clay			
42	47	Caliche and clay with gravelly sand			
47	63	Gravelly sand with clay and caliche			
63	83	Gravelly sand w/clay			
83	95	Shale and yellow ochre			

**Notes:**  
Wakeeney Travel Plaza Site: KDHE Project Code: U6-098-00782

**11 CONTRACTOR'S OR LANDOWNER'S CERTIFICATION:** This water well was  constructed,  reconstructed, or  plugged under my jurisdiction and was completed on (mo-day-year) **10/4/18** ..... and this record is true to the best of my knowledge and belief. Kansas Water Well Contractor's License No. **881** ..... This Water Well Record was completed on (mo-day-year) **11/1/18** ..... under the business name of **Woppter Pump & Well** ..... Signature: *[Signature]*

Trego NW SE NENE

17-12-23

**LEGEND**

- ◆ = MONITORING WELL
- = SOIL BORING
- ⊕ = PLUGGED WELL
- G — = UNDERGROUND GAS
- V — = UNDERGROUND WATER
- DHE — = OVERHEAD ELECTRIC
- T — = TELEPHONE
- S — = SANITARY SEWER
- UCE — = UNDERGROUND ELECTRIC
- --- — = FORMER FUEL PIPING
- X — X — = FENCE
- >— = POWER POLE/LIGHT POLE
- >— = GROUNDWATER FLOW DIRECTION
- ▭ = FORMER TANK BASINS/PUMP ISLANDS
- ▨ = CURRENT TANK BASINS
- - - - = APPROXIMATE PROPERTY LINE

REVISIONS

	BY

**MILCO**  
Environmental Services, Inc.  
Kearney, NE (308) 237-5923  
McCook, NE (308) 345-4741  
Colby, KS (785) 460-1966

Point Designation	Latitude	Longitude
MW-18	39.01261	99.89195
MW-19	39.01647	99.89186
MW-20	39.01334	99.89053

RECEIVED  
NOV 20 2018  
BUREAU OF WATER


0 60 120 240  
SCALE IN FEET

WAKEENEY TRAVEL PLAZA  
**SITE BASE MAP - 350' RADIUS**  
I-70 & HWY 283, WAKEENEY, KANSAS U6-098-00782

SCALE: AS SHOWN  
PROJECT NO. M251-P24-02  
DATE: NOVEMBER, 2018  
FIELD BOOK M&A DWG NO.  
DRAWN BY: BSF  
APR'D BY:  
SHEET

FIGURE 2.1

FEB 04, 2009 • 13:39:42 Location: G:\Projects\251\251-P24-02\KRBCA Addendum 11-2018\Figure 2.1.dwg

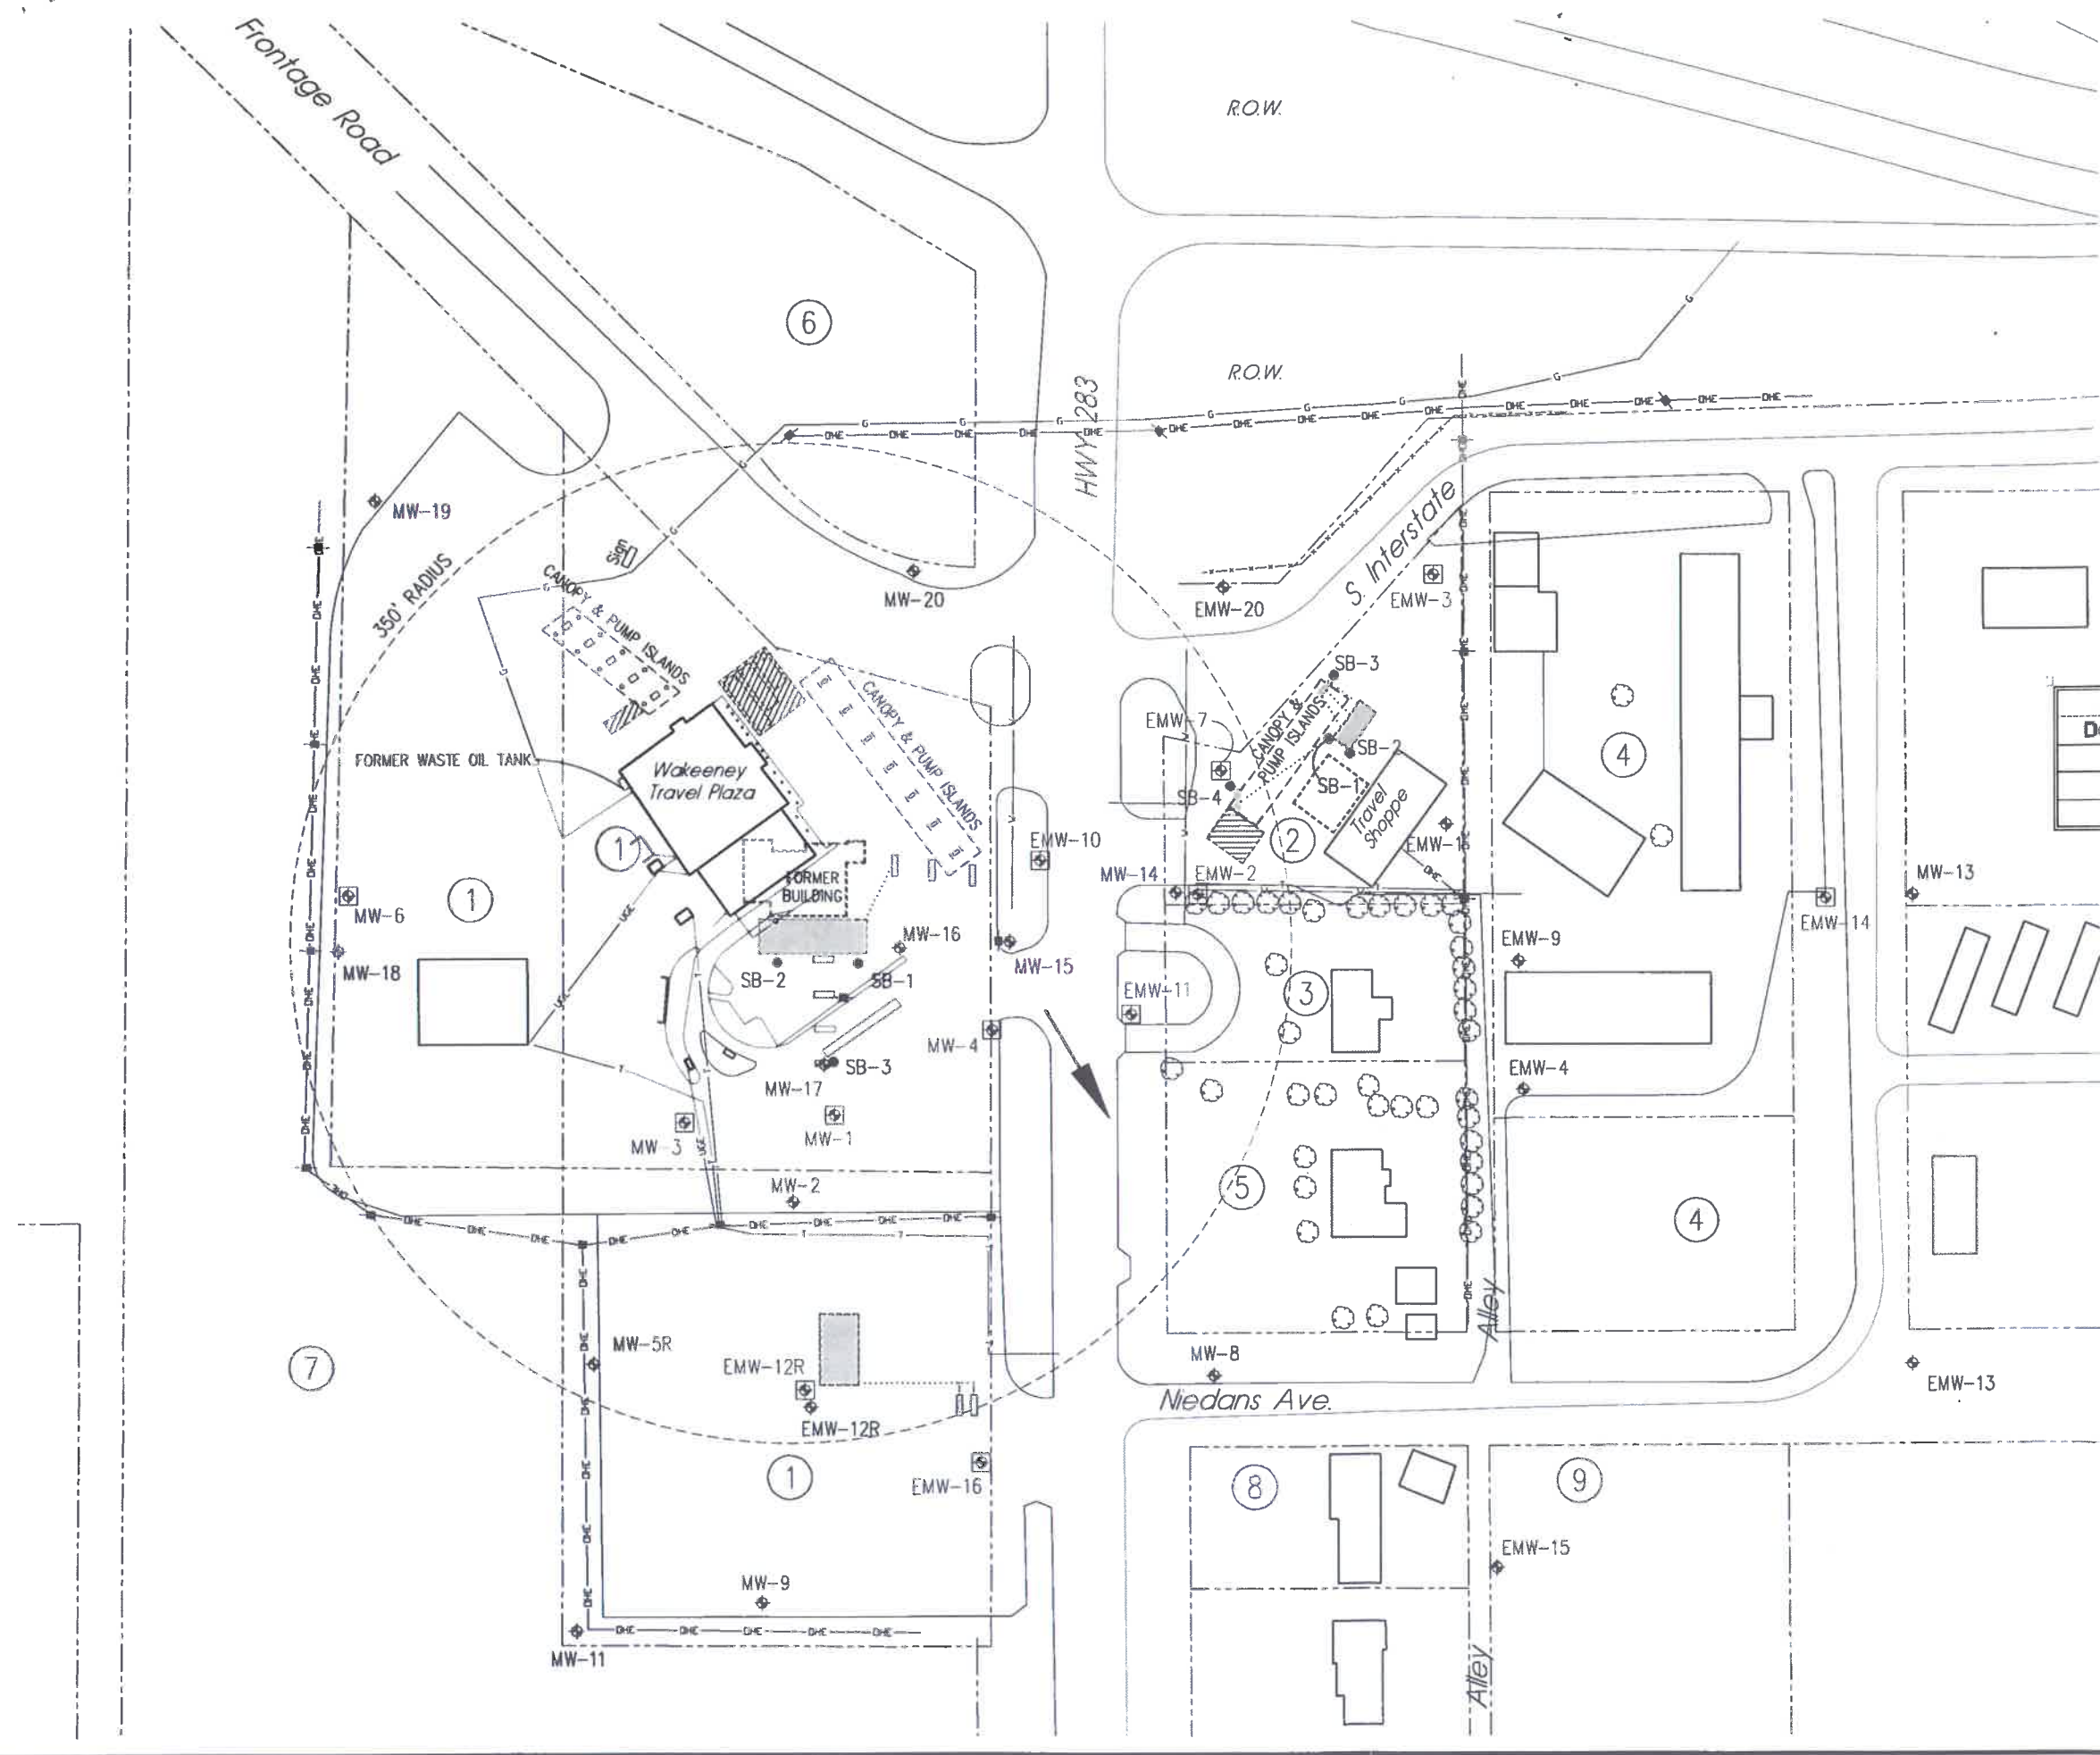

This document, and the ideas and designs incorporated herein, is the property of Milco & Associates and is not to be used in whole or in part, for any other project without the written authorization of Milco & Associates.