


1 LOCATION OF WATER WELL: Fraction SW 1/4 SE 1/4 NW 1/4 Section Number 9 Township Number T 12 S Range Number R 23 **EW**

Distance and direction from nearest town or city street address of well if located within city?
 510 N Railroad, Wakeeney, Ks. 67672 MW 14

2 WATER WELL OWNER: Glen Riggs
 RR#, St. Address, Box #: P.O. Box 223 Board of Agriculture, Division of Water Resources
 City, State, ZIP Code: Wakeeney, Ks. 67672 Application Number:

3 LOCATE WELL'S LOCATION WITH AN "X" IN SECTION BOX:

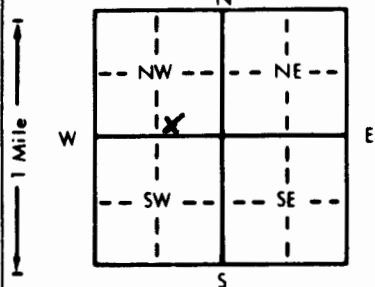

4 DEPTH OF COMPLETED WELL: .88 ft. ELEVATION:
 Depth(s) Groundwater Encountered 1. ft. 2. ft. 3. ft.
 WELL'S STATIC WATER LEVEL .77 .04 ft. below land surface measured on mo/day/yr 10-22-91
 Pump test data: Well water was ft. after hours pumping gpm
 Est. Yield gpm: Well water was ft. after hours pumping gpm
 Bore Hole Diameter ... 7. in. to ... 88. ft., and ... in. to ... ft.
 WELL WATER TO BE USED AS: 5 Public water supply 8 Air conditioning 11 Injection well
 1 Domestic 3 Feedlot 6 Oil field water supply 9 Dewatering 12 Other (Specify below)
 2 Irrigation 4 Industrial 7 Lawn and garden only **10 Monitoring well**
 Was a chemical/bacteriological sample submitted to Department? Yes No **X**; If yes, mo/day/yr sample was submitted
 Water Well Disinfected? Yes No **X**

5 TYPE OF BLANK CASING USED: 5 Wrought iron 8 Concrete tile CASING JOINTS: Glued Clamped
 1 Steel 3 RMP (SR) 6 Asbestos-Cement 9 Other (specify below) Welded
2 PVC 4 ABS 7 Fiberglass Threaded **X**

Blank casing diameter ... 2. in. to ... 68. ft., Dia. in. to ... ft., Dia. in. to ... ft.
 Casing height above land surface ... 0 in., weight lbs./ft. Wall thickness or gauge No. Schedule 40

TYPE OF SCREEN OR PERFORATION MATERIAL: **7 PVC** 10 Asbestos-cement
 1 Steel 3 Stainless steel 5 Fiberglass 8 RMP (SR) 11 Other (specify)
 2 Brass 4 Galvanized steel 6 Concrete tile 9 ABS 12 None used (open hole)

SCREEN OR PERFORATION OPENINGS ARE: 5 Gauzed wrapped 8 Saw cut 11 None (open hole)
 1 Continuous slot **3 Mill slot** 6 Wire wrapped 9 Drilled holes
 2 Louvered shutter 4 Key punched 7 Torch cut 10 Other (specify)

SCREEN-PERFORATED INTERVALS: From ... 68. ft. to ... 88. ft., From ... ft. to ... ft.
 From ... ft. to ... ft., From ... ft. to ... ft.
 GRAVEL PACK INTERVALS: From ... 54. ft. to ... 88. ft., From ... ft. to ... ft.
 From ... ft. to ... ft., From ... ft. to ... ft.

6 GROUT MATERIAL: 1 Neat cement **2 Cement grout** **3 Bentonite** 4 Other
 Grout Intervals: From ... 0. ft. to ... 2'6" (cement), From ... 2' 6" ft. to ... 54 (bent.) ft., From ... ft. to ... ft.

What is the nearest source of possible contamination:
 1 Septic tank 4 Lateral lines 7 Pit privy **11 Fuel storage** 14 Abandoned water well
 2 Sewer lines 5 Cess pool 8 Sewage lagoon 12 Fertilizer storage 15 Oil well/Gas well
 3 Watertight sewer lines 6 Seepage pit 9 Feedyard 13 Insecticide storage 16 Other (specify below)

Direction from well? Northwest How many feet? 75'

| FROM | TO | LITHOLOGIC LOG | FROM | TO | PLUGGING INTERVALS |
|------|----|--|------|----|---|
| 0 | 18 | Clay, brown, silty | | | |
| 18 | 28 | Sand, yellow, fine to coarse chalky | | | KDHE Site Tag No. 00041933 |
| 28 | 48 | Sand, yellow, medium to coarse, chalky | | | |
| 48 | 58 | Sand, yellow, fine to medium | | | This well completed with a flush-mounted well cover |
| 58 | 80 | Sand, yellow, fine to coarse | | | |
| 80 | 88 | Sand, yellow, fine to coarse | | | |

7 CONTRACTOR'S OR LANDOWNER'S CERTIFICATION: This water well was **1) constructed**, (2) reconstructed, or (3) plugged under my jurisdiction and was completed on (mo/day/year) ... 10-7-91. and this record is true to the best of my knowledge and belief. Kansas Water Well Contractor's License No. ... 527. This Water Well Record was completed on (mo/day/yr) ... 10-14-91. under the business name of GeoCore Services, Inc. by (signature) Dale A. Pelt

OFFICE USE ONLY
T
R
EW
SEC.