


1 LOCATION OF WATER WELL: Fraction SW 1/4 SE 1/4 NW 1/4 Section Number 9 Township Number T 12 S Range Number R 23 EW

Distance and direction from nearest town or city street address of well if located within city?
 510 N Railroad, Wakeeney, Ks. 67672 MW 9

2 WATER WELL OWNER: Glen Riggs
 RR#, St. Address, Box #: P.O.Box 223 Board of Agriculture, Division of Water Resources
 City, State, ZIP Code: Wakeeney, Ks. 67672 Application Number:

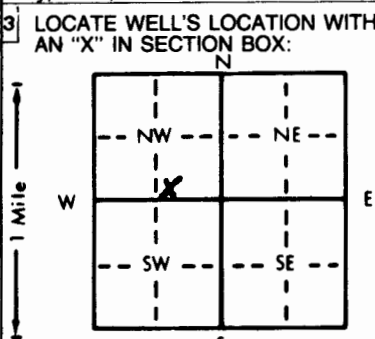

4 DEPTH OF COMPLETED WELL... 87.2... ft. ELEVATION: ...
 Depth(s) Groundwater Encountered 1... ft. 2... ft. 3... ft.
 WELL'S STATIC WATER LEVEL... 77.86... ft. below land surface measured on mo/day/yr... 10-22-91
 Pump test data: Well water was... ft. after... hours pumping... gpm
 Est. Yield... gpm: Well water was... ft. after... hours pumping... gpm
 Bore Hole Diameter... 7... in. to... 87.2... ft., and... in. to... ft.
 WELL WATER TO BE USED AS: 5 Public water supply 8 Air conditioning 11 Injection well
 1 Domestic 3 Feedlot 6 Oil field water supply 9 Dewatering 12 Other (Specify below)
 2 Irrigation 4 Industrial 7 Lawn and garden only 10 Monitoring well
 Was a chemical/bacteriological sample submitted to Department? Yes... No... X... If yes, mo/day/yr sample was submitted
 Water Well Disinfected? Yes No X

5 TYPE OF BLANK CASING USED: 5 Wrought iron 8 Concrete tile CASING JOINTS: Glued... Clamped...
 1 Steel 3 RMP (SR) 6 Asbestos-Cement 9 Other (specify below) Welded...
 2 PVC 4 ABS 7 Fiberglass Threaded... X
 Blank casing diameter... 4... in. to... 64... ft., Dia... in. to... ft., Dia... in. to... ft.
 Casing height above land surface... 0... in., weight... lbs./ft. Wall thickness or gauge No. Schedule 40
 TYPE OF SCREEN OR PERFORATION MATERIAL: 7 PVC 10 Asbestos-cement
 1 Steel 3 Stainless steel 5 Fiberglass 8 RMP (SR) 11 Other (specify)...
 2 Brass 4 Galvanized steel 6 Concrete tile 9 ABS 12 None used (open hole)
 SCREEN OR PERFORATION OPENINGS ARE: 5 Gauzed wrapped 8 Saw cut 11 None (open hole)
 1 Continuous slot 3 Mill slot 6 Wire wrapped 9 Drilled holes
 2 Louvered shutter 4 Key punched 7 Torch cut 10 Other (specify)...
 SCREEN-PERFORATED INTERVALS: From... 64... ft. to... 84... ft., From... ft. to... ft.
 GRAVEL PACK INTERVALS: From... 46... ft. to... 84... ft., From... ft. to... ft.

6 GROUT MATERIAL: 1 Neat cement 2 Cement grout 3 Bentonite 4 Other
 Grout Intervals: From... 0... ft. to... 2 (cement) ft., From... 2... ft. to... 46 (bent) ft., From... ft. to... ft.
 What is the nearest source of possible contamination:
 1 Septic tank 4 Lateral lines 7 Pit privy 10 Livestock pens 14 Abandoned water well
 2 Sewer lines 5 Cess pool 8 Sewage lagoon 11 Fuel storage 15 Oil well/Gas well
 3 Watertight sewer lines 6 Seepage pit 9 Feedyard 12 Fertilizer storage 16 Other (specify below)
 13 Insecticide storage
 Direction from well? North How many feet? 20'

| FROM | TO | LITHOLOGIC LOG | FROM | TO | PLUGGING INTERVALS |
|------|------|-------------------------------------|------|----|---|
| 0 | 18 | Clay, brown, silty | | | |
| 18 | 25 | Chalk, white, silty clay | | | |
| 25 | 30 | Sand, yellow, medium to coarse | | | KHE Site Tag No. 00041940 |
| 30 | 36 | Sand, yellow, fine to medium | | | |
| 36 | 66 | Sand, yellow, medium to coarse | | | This well completed with a flush-mounted well cover |
| 66 | 70 | Chalk, white | | | |
| 70 | 87 | Sand, yellow, medium to very coarse | | | |
| 87 | 87.2 | Shale, dark green | | | |

7 CONTRACTOR'S OR LANDOWNER'S CERTIFICATION: This water well was (1) constructed (2) reconstructed, or (3) plugged under my jurisdiction and was completed on (mo/day/year) 10-7-91 and this record is true to the best of my knowledge and belief. Kansas Water Well Contractor's License No. 527 This Water Well Record was completed on (mo/day/yr) 10-14-91 under the business name of GeoCore Services, Inc. by signature Dale Bell

INSTRUCTIONS: Use typewriter or ball point pen. PLEASE PRESS FIRMLY and PRINT clearly. Please fill in blanks, underline or circle the correct answers. Send top three copies to Kansas Department of Health and Environment, Bureau of Water, Topeka, Kansas 66620-0001. Telephone: 913-296-5545. Send one to WATER WELL OWNER and retain one for your records.

OFFICE USE ONLY
T
R
EW
SEC.