

1 LOCATION OF WATER WELL: County: Trego	Fraction SW 1/4 SE 1/4 NW 1/4	Section Number 9	Township Number T 12 S	Range Number R 23 EW
---	---	----------------------------	----------------------------------	--------------------------------


Distance and direction from nearest town or city street address of well if located within city?

510 North Railroad

2 WATER WELL OWNER: **Glen Riggs**
 RR#, St. Address, Box # : **P.O. Box 223**
 City, State, ZIP Code : **WaKeeney, Ks. 67672**

Board of Agriculture, Division of Water Resources
Application Number:

3 LOCATE WELL'S LOCATION WITH AN "X" IN SECTION BOX:

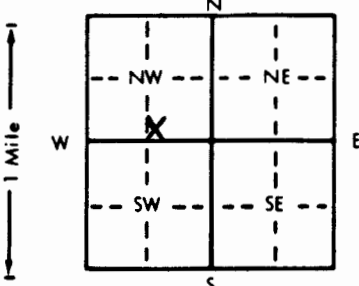

4 DEPTH OF COMPLETED WELL: **90.4** ft. ELEVATION: _____

Depth(s) Groundwater Encountered 1. **74** ft. 2. _____ ft. 3. _____ ft.

WELL'S STATIC WATER LEVEL _____ ft. below land surface measured on mo/day/yr

Pump test data: Well water was _____ ft. after _____ hours pumping _____ gpm

Est. Yield _____ gpm: Well water was _____ ft. after _____ hours pumping _____ gpm

Bore Hole Diameter _____ in. to _____ ft., and _____ in. to _____ ft.

WELL WATER TO BE USED AS:

5 Public water supply	8 Air conditioning	11 Injection well
1 Domestic	3 Feedlot	6 Oil field water supply
2 Irrigation	4 Industrial	7 Lawn and garden only
		10 Monitoring well

9 Dewatering
12 Other (Specify below)

Was a chemical/bacteriological sample submitted to Department? Yes _____ No If yes, mo/day/yr sample was submitted _____

Water Well Disinfected? Yes _____ No _____

5 TYPE OF BLANK CASING USED:

1 Steel	3 RMP (SR)	5 Wrought iron	8 Concrete tile	CASING JOINTS: Glued _____ Clamped _____
2 PVC	4 ABS	6 Asbestos-Cement	9 Other (specify below)	Welded _____
		7 Fiberglass		Threaded <input checked="" type="checkbox"/>

Blank casing diameter _____ in. to **70.4** ft., Dia _____ in. to _____ ft., Dia _____ in. to _____ ft.

Casing height above land surface _____ in., weight _____ lbs./ft. Wall thickness or gauge No. **Sch. 40**

TYPE OF SCREEN OR PERFORATION MATERIAL:

1 Steel	3 Stainless steel	5 Fiberglass	7 PVC	10 Asbestos-cement
2 Brass	4 Galvanized steel	6 Concrete tile	8 RMP (SR)	11 Other (specify) _____
			9 ABS	12 None used (open hole)

SCREEN OR PERFORATION OPENINGS ARE:

1 Continuous slot	3 Mill slot	5 Gauzed wrapped	8 Saw cut	11 None (open hole)
2 Louvered shutter	4 Key punched	6 Wire wrapped	9 Drilled holes	
		7 Torch cut	10 Other (specify) _____	

SCREEN-PERFORATED INTERVALS: From **70.4** ft. to **90.4** ft., From _____ ft. to _____ ft., From _____ ft. to _____ ft.

GRAVEL PACK INTERVALS: From **65.7** ft. to **90.4** ft., From _____ ft. to _____ ft., From _____ ft. to _____ ft.

6 GROUT MATERIAL: 1 Neat cement 2 **Cement grout** 3 **Bentonite** 4 Other _____

Grout Intervals: From **0** ft. to **6** ft., From **6** ft. to **59.9** ft., From **59.9** ft. to **65.7** ft.

What is the nearest source of possible contamination:

1 Septic tank	4 Lateral lines	7 Pit privy	11 Fuel storage	14 Abandoned water well
2 Sewer lines	5 Cess pool	8 Sewage lagoon	12 Fertilizer storage	15 Oil well/Gas well
3 Watertight sewer lines	6 Seepage pit	9 Feedyard	13 Insecticide storage	16 Other (specify below)

Direction from well? **west** How many feet? **200**

FROM	TO	LITHOLOGIC LOG	FROM	TO	PLUGGING INTERVALS
0	4"	CONCRETE			
4"	3'	CLY, DK BRN, SLTY			Flush mount cover
3	13	CLY, LT BRN, SLTY			MW17
13	22	CLY, BRN, SLTY, TR CALICHE			
22	37	SND, LT BRN, F TO M, SRTD			
37	41	CLY, BRN, SLTY, TR CALICHE			
41	44	CALICHE, WH			
44	46	CLY, BRN, SNDY			
46	50	SND, LT BRN, M TO V C, SRTD			
50	67	CLY, BRN, TR CALICHE			
67	70	SND, LT BRN, CEMENTED			
70	87	SND, LT BRN, M TO V C, TR F TO M GRVL			
87	90	CALICHE			

7 CONTRACTOR'S OR LANDOWNER'S CERTIFICATION: This water well was **1** constructed, **2** reconstructed, or **3** plugged under my jurisdiction and was completed on (mo/day/year) **05-20-93** and this record is true to the best of my knowledge and belief. Kansas Water Well Contractor's License No. **527** This Water Well Record was completed on (mo/day/yr) **06-08-93** under the business name of **GeoCore Services, Inc.** by (signature) *Doug Ray*

INSTRUCTIONS: Use typewriter or ball point pen. PLEASE PRESS FIRMLY and PRINT clearly. Please fill in blanks, underline or circle the correct answers. Send top three copies to Kansas Department of Health and Environment, Bureau of Water, Topeka, Kansas 66620-0001. Telephone: 913-296-5545. Send one to WATER WELL OWNER and retain one for your records.