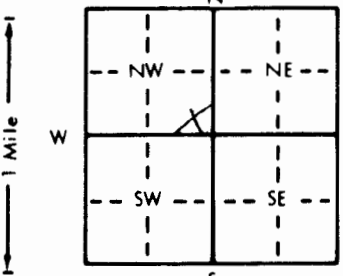


1 LOCATION OF WATER WELL:		Fraction	Section Number	Township Number	Range Number	
County: Trego		SE 1/4 SE 1/4 NW 1/4	9	T 12 S	R 23 E	
Distance and direction from nearest town or city street address of well if located within city? 100 6th Street	
2 WATER WELL OWNER: Harries Motor Co., Inc.	
RR#, St. Address, Box # : 100 6th		Board of Agriculture, Division of Water Resources	
City, State, ZIP Code : Wakeeney, Ks. 67672		MW #1		Application Number:	
3 LOCATE WELL'S LOCATION WITH AN "X" IN SECTION BOX:		4 DEPTH OF COMPLETED WELL: 84 ft. ELEVATION:	
<div style="text-align: center;"></div>		Depth(s) Groundwater Encountered 1. ft. 2. ft. 3. ft.	
		WELL'S STATIC WATER LEVEL 73.13 ft. below land surface measured on mo/day/yr	
		Pump test data: Well water was ft. after hours pumping gpm	
		Est. Yield gpm: Well water was ft. after hours pumping gpm	
		Bore Hole Diameter 6 in. to 84 ft., and in. to ft.	
WELL WATER TO BE USED AS: 5 Public water supply 8 Air conditioning 11 Injection well	
1 Domestic 3 Feedlot 6 Oil field water supply 9 Dewatering 12 Other (Specify below)	
2 Irrigation 4 Industrial 7 Lawn and garden only 10 Monitoring well	
Was a chemical/bacteriological sample submitted to Department? Yes.....No..... X; If yes, mo/day/yr sample was submitted	
Water Well Disinfected? Yes No X	
5 TYPE OF BLANK CASING USED:	
1 Steel		3 RMP (SR)	5 Wrought iron	8 Concrete tile	CASING JOINTS: Glued Clamped	
2 PVC		4 ABS	6 Asbestos-Cement	9 Other (specify below)	Welded	
			7 Fiberglass		Threaded..... X	
Blank casing diameter 2 in. to 64 ft., Dia in. to ft., Dia in. to ft.	
Casing height above land surface 0 in., weight 716 lbs./ft. Wall thickness or gauge No. 154	
TYPE OF SCREEN OR PERFORATION MATERIAL:	
1 Steel		3 Stainless steel	5 Fiberglass	7 PVC	10 Asbestos-cement	
2 Brass		4 Galvanized steel	6 Concrete tile	8 RMP (SR)	11 Other (specify)	
				9 ABS	12 None used (open hole)	
SCREEN OR PERFORATION OPENINGS ARE:	
1 Continuous slot		3 Mill slot	5 Gauzed wrapped	8 Saw cut	11 None (open hole)	
2 Louvered shutter		4 Key punched	6 Wire wrapped	9 Drilled holes	
			7 Torch cut	10 Other (specify)	
SCREEN-PERFORATED INTERVALS: From 64 ft. to 84 ft., From ft. to ft.	
From ft. to ft., From ft. to ft.	
GRAVEL PACK INTERVALS: From 61 ft. to 84 ft., From ft. to ft.	
From ft. to ft., From ft. to ft.	
6 GROUT MATERIAL: 1 Neat cement 2 Cement grout 3 Bentonite 4 Other	
Grout Intervals: From 0 ft. to 57 ft., From 57 ft. to 61 ft., From ft. to ft.	
What is the nearest source of possible contamination:	
1 Septic tank		4 Lateral lines	7 Pit privy	10 Livestock pens	14 Abandoned water well	
2 Sewer lines		5 Cess pool	8 Sewage lagoon	11 Fuel storage	15 Oil well/Gas well	
3 Watertight sewer lines		6 Seepage pit	9 Feedyard	12 Fertilizer storage	16 Other (specify below)	
				13 Insecticide storage	Removed Fuel Storage	
Direction from well? How many feet?	
<table border="1" style="width:100%; border-collapse: collapse;"><thead><tr><th>FROM</th><th>TO</th><th>LITHOLOGIC LOG</th><th>FROM</th><th>TO</th><th>PLUGGING INTERVALS</th></tr></thead><tbody><tr><td>0</td><td>.6</td><td>Cement</td><td>69</td><td>76</td><td>Weathered Shale</td></tr><tr><td>.6</td><td>5</td><td>Loess</td><td>76</td><td>84</td><td>Med. Sand</td></tr><tr><td>5</td><td>10</td><td>Loess</td><td>84</td><td></td><td>Hard Caliche</td></tr><tr><td>10</td><td>15</td><td>Clay w/Caliche</td><td></td><td></td><td></td></tr><tr><td>15</td><td>20</td><td>Sandy Clay w/Caliche & Some Sand</td><td></td><td></td><td></td></tr><tr><td>20</td><td>25</td><td>Sandy Clay & Caliche w/Some Sand</td><td></td><td></td><td></td></tr><tr><td>25</td><td>30</td><td>Med. Sand w/Clay Strks.</td><td></td><td></td><td></td></tr><tr><td>30</td><td>36</td><td>Med. Sand</td><td></td><td></td><td></td></tr><tr><td>36</td><td>40</td><td>Cemented Sand w/Clay Strks.</td><td></td><td></td><td></td></tr><tr><td>40</td><td>47</td><td>Loose Fine to Med. Sand w/Fine Clay Lenses</td><td></td><td></td><td></td></tr><tr><td>47</td><td>51</td><td>Cemented Sand</td><td></td><td></td><td></td></tr><tr><td>51</td><td>56</td><td>Loose Sand</td><td></td><td></td><td></td></tr><tr><td>56</td><td>60</td><td>Cemented Sand w/Some Sand</td><td></td><td></td><td></td></tr><tr><td>60</td><td>66</td><td>Hard Cemented Sand</td><td></td><td></td><td></td></tr><tr><td>66</td><td>69</td><td>Med. Sand</td><td></td><td></td><td></td></tr>
7 CONTRACTOR'S OR LANDOWNER'S CERTIFICATION: This water well was (1) constructed, (2) reconstructed, or (3) plugged under my jurisdiction and was completed on (mo/day/year) 5-4-94 and this record is true to the best of my knowledge and belief. Kansas Water Well Contractor's License No. 554 This Water Well Record was completed on (mo/day/yr) 7-1-94 under the business name of Woofter Pump & Well, Inc. by (signature) <i>[Signature]</i>	
INSTRUCTIONS: Use typewriter or ball point pen. PLEASE PRESS FIRMLY and PRINT clearly. Please fill in blanks, underline or circle the correct answers. Send top three copies to Kansas Department of Health and Environment, Bureau of Water, Topeka, Kansas 66620-0001 Telephone: 913-296-5545. Send one to WATER WELL OWNER and retain one for your records.	