

County: Trego Fraction SE NE NW NW Sec. 31 T 12 S R 24 E (W)

CORRECTION(S) TO WATER WELL COMPLETION RECORD (WWC-5)
(to rectify lacking or incorrect information)

Owner: Don Mosher

Location was listed as:

Location changed to:

Section-Township-Range: 31-125-24W

31-125-24W

Fraction (1/4 1/4 1/4): None Given

SE NE NW NW

Other changes: Initial statements: _____

Changed to: _____

Comments: _____

Verification method: written & legal descriptions, area road map, and mapping tool & aerial photos on KGS website.


initials: ORA date: 11/18/2013

Submitted by: Kansas Geological Survey, Data Resources Library, 1930 Constant Ave., Lawrence, KS 66047-3726
to: Kansas Dept of Health & Environment, Bureau of Water, 1000 SW Jackson, Suite 420, Topeka, KS 66612-1367.

1 LOCATION OF WATER WELL: County: <u>Trego</u>	Fraction $\frac{1}{4}$ $\frac{1}{4}$ $\frac{1}{4}$	Section Number <u>31</u>	Township Number <u>12S</u>	Range Number <u>24 W E/W</u>
---	---	-----------------------------	-------------------------------	---------------------------------

Distance and direction from nearest town or city street address of well if located within city?
From Wakeeney I-70-283 go South to Amd Then West to 170 Av Then North into pasture about 1/2 mile Then East into Pasture to Windmill site

2 WATER WELL OWNER: <u>Don Mosher</u> RR#, St. Address, Box #: <u>909 4th</u> City, State ZIP Code: <u>Wakeeney KS 67672</u>	Global Positioning Systems (decimal degrees, min. of 4 digits) Latitude: _____ Longitude: _____ Elevation: _____ Datum: _____ Data Collection Method: _____
---	--

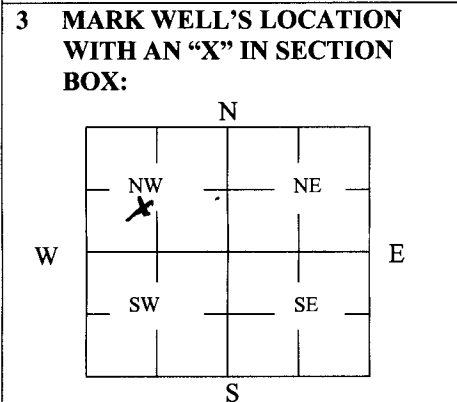

4 DEPTH OF WELL 73 ft.
 WELL'S STATIC WATER LEVEL 65 ft.
 WELL WAS USED AS:

1 Domestic	5 Public Water Supply	9 Dewatering
2 Irrigation	6 Oil Field Water Supply	10 Monitoring
3 Feedlot - <u>Pasture</u>	7 Domestic (Lawn & Garden)	11 Injection Well
4 Industrial	8 Air Conditioning	12 Other _____

Was a chemical/bacteriological sample submitted to Department? Yes _____ No

5 TYPE OF BLANK CASING USED:

<input checked="" type="checkbox"/> 1 Steel	3 RMP (SR)	5 Wrought	7 Fiberglass	9 Other (Specify below)
2 PVC	4 ABS	6 Asbestos-Cement	8 Concrete Tile	_____

Blank casing diameter 5 in. Was casing pulled? Yes No _____ If yes, how much 6'
 Casing height above or below land surface 60 in.

6 GROUT PLUG MATERIAL: 1 Neat cement 2 Cement grout Bentonite 4 Other _____

Grout Plug Intervals: From 10 ft. to 20 ft., From _____ ft. to _____ ft., From _____ to _____ ft.

What is the nearest source of possible contamination:

1 Septic tank	6 Seepage pit	11 Fuel Storage	16 Other (specify below)
2 Sewer lines	7 Pit privy	12 Fertilizer storage	_____
3 Watertight sewer lines	8 Sewage lagoon	13 Insecticide storage	_____
4 Lateral lines	<input checked="" type="checkbox"/> <u>9 Feedyard</u>	<input checked="" type="checkbox"/> <u>14 Abandoned water well</u>	Direction from well? _____
5 Cess pool	10 Livestock pens	15 Oil well/Gas well	How many feet? _____

FROM	TO	PLUGGING MATERIALS	FROM	TO	PLUGGING MATERIALS
<u>0</u>	<u>10</u>	<u>Clay Soil</u>			
<u>10</u>	<u>20</u>	<u>Bentonite</u>			
<u>20</u>	<u>62</u>	<u>Clean Clay Soil</u>			
<u>62</u>	<u>73</u>	<u>Clean Wash Sand</u>			

7 CONTRACTOR'S OR LANDOWNER'S CERTIFICATION: This water well was plugged under my jurisdiction and was completed on (mo/day/year) 5-29-12 and this record is true to the best of my knowledge and belief. Kansas Water Well Contractor's License No. _____. This Water Well Record was completed on (mo/day/year) _____ under the business name of Bolly & Ditching & Well by (signature) Elli Bolly

INSTRUCTIONS: Use typewriter or ballpoint pen. Please press firmly and print clearly. Please fill in blanks, underline or circle the correct answers. Send top three copies to Kansas Department of Health and Environment, Bureau of Water, Geology Section, 1000 SW Jackson St., Ste. 420, Topeka, Kansas 66612-1367. Telephone: 785/296-5522. Send one to Water Well Owner and retain one for your records. Visit us at <http://www.kdheks.gov/geo/waterwells>.