


WATER WELL PLUGGING RECORD Form WWC-5P KSA 82a-1212 ID NO.

1 LOCATION OF WATER WELL: County: <u>Trego</u>	Eraction <u>SW 1/4 SW 1/4 NW 1/4</u>	Section Number <u>22</u>	Township Number <u>12 S</u>	Range Number <u>24</u> 25
--	---	-----------------------------	--------------------------------	---

Distance and direction from nearest town or city street address of well if located within city?
 From: CR-J and 200 AVE go South 1/2 m Then East into yard

2 WATER WELL OWNER: RR#, St. Address, Box #: <u>Shinley Mai 624 3rd</u> City, State ZIP Code: <u>Wakeeney KS 67672</u>	Global Positioning Systems (decimal degrees, min. of 4 digits) Latitude: _____ Longitude: _____ Elevation: _____ Datum: _____ Data Collection Method: _____
---	---

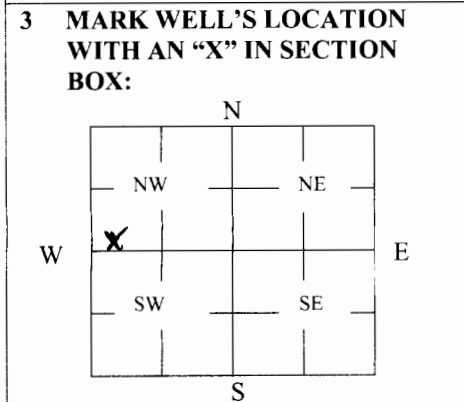

4 DEPTH OF WELL 76 ft.

WELL'S STATIC WATER LEVEL 46 ft

WELL WAS USED AS:

<input checked="" type="checkbox"/> 1 Domestic	5 Public Water Supply	9 Dewatering
<input type="checkbox"/> 2 Irrigation	6 Oil Field Water Supply	10 Monitoring
<input type="checkbox"/> 3 Feedlot	7 Domestic (Lawn & Garden)	11 Injection Well
<input type="checkbox"/> 4 Industrial	8 Air Conditioning	12 Other _____

Was a chemical/bacteriological sample submitted to Department? Yes _____ No

5 TYPE OF BLANK CASING USED:

<input checked="" type="checkbox"/> 1 Steel	3 RMP (SR)	5 Wrought	7 Fiberglass	9 Other (Specify below)
<input type="checkbox"/> 2 PVC	4 ABS	6 Asbestos-Cement	8 Concrete Tile	_____

Blank casing diameter 5 in. Was casing pulled? Yes No _____ If yes, how much 7 FT

Casing height above or below land surface 84 in.

6 GROUT PLUG MATERIAL: 1 Neat cement 2 Cement grout 3 Bentonite 4 Other _____

Grout Plug Intervals: From 10 ft. to 20 ft., From _____ ft. to _____ ft., From _____ to _____ ft.

What is the nearest source of possible contamination:

1 Septic tank	6 Seepage pit	11 Fuel Storage	16 Other (specify below)
2 Sewer lines	7 Pit privy	12 Fertilizer storage	_____
3 Watertight sewer lines	8 Sewage lagoon	13 Insecticide storage	_____
4 Lateral lines	<input checked="" type="checkbox"/> 9 Feedyard	14 Abandoned water well	Direction from well? <u>South</u>
5 Cess pool	10 Livestock pens	15 Oil well/Gas well	How many feet? <u>50</u>

FROM	TO	PLUGGING MATERIALS	FROM	TO	PLUGGING MATERIALS
<u>0</u>	<u>10</u>	<u>Clay Soil</u>			
<u>10</u>	<u>20</u>	<u>Bentonite</u>			
<u>20</u>	<u>40</u>	<u>Clean Clay Soil</u>			
<u>40</u>	<u>76</u>	<u>Clean Sand</u>			

7 CONTRACTOR'S OR LANDOWNER'S CERTIFICATION: This water well was plugged under my jurisdiction and was completed on (mo/day/year) 4/14/11 and this record is true to the best of my knowledge and belief. Kansas Water Well Contractor's License No. _____. This Water Well Record was completed on (mo/day/year) 4/14/11 under the business name of Bollig Ditching & Well Service by (signature) Eddie Bollig

INSTRUCTIONS: Use typewriter or ballpoint pen. Please press firmly and print clearly. Please fill in blanks, underline or circle the correct answers. Send top three copies to Kansas Department of Health and Environment, Bureau of Water, Geology Section, 1000 SW Jackson St., Ste. 420, Topeka, Kansas 66612-1367. Telephone: 785/296-5522. Send one to Water Well Owner and retain one for your records. Visit us at <http://www.kdheks.gov/geo/waterwells>.