

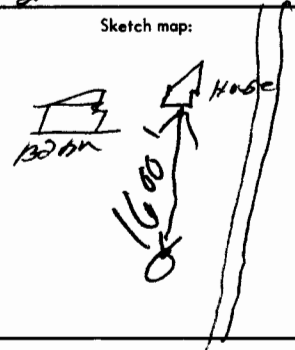
USE TYPEWRITER OR BALL POINT PEN—PRESS FIRMLY, PRINT CLEARLY.

Trigo water

WATER WELL RECORD
KSA 82a-1201-1215

Kansas Department of Health and Environment—Division of Environment
(Water well Contractors)
Topeka, Kansas 66620

D151

1. Location of well: County TRIGO		Fraction SE 1/4 SE 1/4 SE 1/4		Section number 21		Township number T 12 S R 24 E/W		Range number	
2. Distance and direction from nearest town or city: 1 South & 5 West & AAA, 1/2 South.				3. Owner of well: Richard Doines R.R. or street: R.R. City, state, zip code: WAKEFORD, Kan					
4. Locate with "X" in section below: N W E S 1 Mile 1 Mile				Sketch map: 		6. Bore hole dia. 3.8 in. Completion date 7-14-76 Well depth 166 ft.			
5. Type and color of material				From		To		7. <input type="checkbox"/> Cable tool <input type="checkbox"/> Rotary <input type="checkbox"/> Driven <input type="checkbox"/> Dug <input type="checkbox"/> Hollow rod <input type="checkbox"/> Jetted <input type="checkbox"/> Bored <input checked="" type="checkbox"/> Reverse rotary	
Sandy clay				0		11		8. Use: <input type="checkbox"/> Domestic <input type="checkbox"/> Public supply <input type="checkbox"/> Industry <input checked="" type="checkbox"/> Irrigation <input type="checkbox"/> Air conditioning <input type="checkbox"/> Stock <input type="checkbox"/> Lawn <input type="checkbox"/> Oil field water <input type="checkbox"/> Other	
Sand with blue mud streaks				14		49		9. Casing: Material TRANSITE Height: Above or below Threaded <input type="checkbox"/> Welded <input type="checkbox"/> Surface 17 in. RMP <input type="checkbox"/> PVC <input type="checkbox"/> Weight 15 lbs./ft. Dia. 4 1/2 in. to 4 1/2 ft. depth; Wall Thickness: inches or Dia. <input type="checkbox"/> in. to <input type="checkbox"/> ft. depth; gage No. 19	
Brown clay				49		55		10. Screen: Manufacturer's name JOHANSON Mfg. Co. Type FRASER Dia. 16" Slot/gauze 3/16 Length 52 1/2 Set between 14 ft. and 46 ft. <input type="checkbox"/> ft. and <input type="checkbox"/> ft.	
Sand & clay STRIPS				55		64		11. Static water level: mo./day/yr. 15 ft. below land surface Date 7-14-76	
clay				64		66		12. Pumping level below land surfaces: 64 ft. after 6 hrs. pumping 250 g.p.m. <input type="checkbox"/> ft. after <input type="checkbox"/> hrs. pumping <input type="checkbox"/> g.p.m. Estimated maximum yield 250 g.p.m.	
64 15 49 sat				2419 64 2355				13. Water sample submitted: mo./day/yr. Yes <input checked="" type="checkbox"/> No <input type="checkbox"/> Date	
119' sat fluck in Og.								14. Well head completion: NO <input type="checkbox"/> Pitless adapter <input type="checkbox"/> Inches above grade	
								15. Well grouted? YES With: <input type="checkbox"/> Neat cement <input checked="" type="checkbox"/> Bentonite <input type="checkbox"/> Concrete Depth: From 0 ft. to 10 ft.	
								16. Nearest source of possible contamination: ft. 600 Direction South Type farm Well disinfected upon completion? <input type="checkbox"/> Yes <input checked="" type="checkbox"/> No	
								17. Pump: <input checked="" type="checkbox"/> Not installed Manufacturer's name _____ Model number _____ HP _____ Volts _____ Length of drop pipe _____ ft. capacity _____ g.p.m. Type: <input type="checkbox"/> Submersible <input type="checkbox"/> Turbine <input type="checkbox"/> Jet <input type="checkbox"/> Reciprocating <input type="checkbox"/> Centrifugal <input type="checkbox"/> Other	
(Use a second sheet if needed)									
18. Elevation:		19. Remarks: 2419							
Topography: <input checked="" type="checkbox"/> Hill <input checked="" type="checkbox"/> Slope <input type="checkbox"/> Upland <input type="checkbox"/> Valley		20. Water well contractor's certification: This well was drilled under my jurisdiction and this report is true to the best of my knowledge and belief. ALL PAINTING CO. License No. 303 Address Hill City, Kan. 67642 Signed allan thomson Date 8-28-76 Authorized representative							

T 12 S R 24 E W 1/4 1/4 1/4 1/4

Forward the white, blue and pink copies to the Department of Health and Environment

Form WWC-3