

CORRECTION(S) TO WATER WELL RECORD (WWC-5)
(to rectify lacking or incorrect information)

County: Trego

Location listed as:

Location changed to:

Section-Township-Range: 33-125-25W

33-125-25W

Fraction ($\frac{1}{4}$ $\frac{1}{4}$ $\frac{1}{4}$): None Given

SW SW NW SW

Other changes: Initial statements: _____

Changed to: _____

Comments: _____

verification method: written & legal descriptions, position on plat map,
and mapping tool & aerial photos on KGS website.

initials: ARA date: 5/25/2012

submitted by: Kansas Geological Survey, Data Resources Library, 1930 Constant Ave., Lawrence, KS 66047-3726
to: Kansas Dept of Health & Environment, Bureau of Water, 1000 SW Jackson, Suite 420, Topeka, KS 66612-1367.


1

WATER WELL PLUGGING RECORD Form WWC-5P KSA 82a-1212 ID NO. []

1 LOCATION OF WATER WELL: Fraction 1/4 1/4 1/4 Section Number 33 Township Number 12 S Range Number 25 EW

Distance and direction from nearest town or city street address of well if located within city? From Collyer Go 4 1/2 m South on 130 AV Then East into yard

2 WATER WELL OWNER: Richard Ziegler RR#, St. Address, Box #: 9626 South Coltfoot City, State ZIP Code: Parker, CO, 80134 Global Positioning Systems (decimal degrees, min. of 4 digits Latitude: Longitude: Elevation: Datum: Data Collection Method:

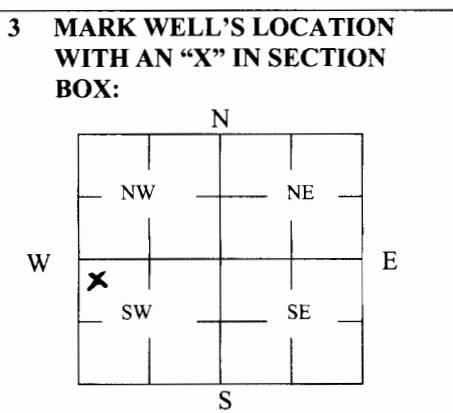

3 MARK WELL'S LOCATION WITH AN "X" IN SECTION BOX: 4 DEPTH OF WELL 89 ft. WELL'S STATIC WATER LEVEL 70 ft. WELL WAS USED AS: 1 Domestic 2 Irrigation 3 Feedlot 4 Industrial 5 Public Water Supply 6 Oil Field Water Supply 7 Domestic (Lawn & Garden) 8 Air Conditioning 9 Dewatering 10 Monitoring 11 Injection Well 12 Other Was a chemical/bacteriological sample submitted to Department? Yes No X

5 TYPE OF BLANK CASING USED: 1 Steel 2 PVC 3 RMP (SR) 4 ABS 5 Wrought 6 Asbestos-Cement 7 Fiberglass 8 Concrete Tile 9 Other (Specify below) Blank casing diameter 5 in. Was casing pulled? Yes X No If yes, how much 9 ft Casing height above or below land surface 90 in. Blow

6 GROUT PLUG MATERIAL: 1 Neat cement 2 Cement grout 3 Bentonite 4 Other Grout Plug Intervals: From 60 ft. to 58 ft., From 12 ft. to 8 ft., From to ft.

What is the nearest source of possible contamination: 1 Septic tank 2 Sewer lines 3 Watertight sewer lines 4 Lateral lines 5 Cess pool 6 Seepage pit 7 Pit privy 8 Sewage lagoon 9 Feedyard 10 Livestock pens 11 Fuel Storage 12 Fertilizer storage 13 Insecticide storage 14 Abandoned water well 15 Oil well/Gas well 16 Other (specify below) Direction from well? S/W How many feet? 65

FROM	TO	PLUGGING MATERIALS	FROM	TO	PLUGGING MATERIALS
89	65	Clean Sand			
65	58	Bentonite			
58	12	Clean Clay Soil			
12	8	Bentonite			

7 CONTRACTOR'S OR LANDOWNER'S CERTIFICATION: This water well was plugged under my jurisdiction and was completed on (mo/day/year) 4-2-12 and this record is true to the best of my knowledge and belief. Kansas Water Well Contractor's License No. This Water Well Record was completed on (mo/day/year) 4-3-12 under the business name of Bolly's Ditching by (signature) Eddie Bolly's

INSTRUCTIONS: Use typewriter or ballpoint pen. Please press firmly and print clearly. Please fill in blanks, underline or circle the correct answers. Send top three copies to Kansas Department of Health and Environment, Bureau of Water, Geology Section, 1000 SW Jackson St., Ste. 420, Topeka, Kansas 66612-1367. Telephone: 785/296-5522. Send one to Water Well Owner and retain one for your records. Visit us at http://www.kdheks.gov/geo/waterwells.