


1 LOCATION OF WATER WELL: Fraction **NE 1/4 NW 1/4 SE 1/4** Section Number **5** Township Number **T 12 S** Range Number **R 25 E**

Distance and direction from nearest town or city street address of well if located within city?
BLOCK 22 - AINSLIE AVE - CULLYER KS.

2 WATER WELL OWNER: **TREGO COUNTY HIGHWAY DEPT. - 120 S MAIN - WAKEENEY KS 67672**
 RR#, St. Address, Box #: **CITY OF CULLYER - CULLYER KS - 67631**
 City, State, ZIP Code: _____
 Board of Agriculture, Division of Water Resources
 Application Number: _____

3 LOCATE WELL'S LOCATION WITH AN "X" IN SECTION BOX:

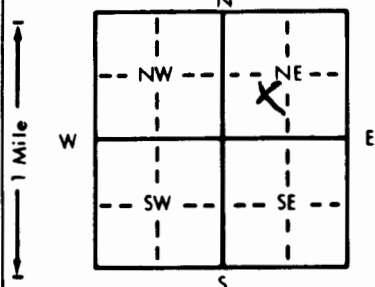

4 DEPTH OF COMPLETED WELL: **80.5** ft. ELEVATION: **2508.58**
 Depth(s) Groundwater Encountered 1. **72.1** ft. 2. _____ ft. 3. _____ ft.
 WELL'S STATIC WATER LEVEL: **71.79** ft. below land surface measured on mo/day/yr **10-02-92**
 Pump test data: Well water was _____ ft. after _____ hours pumping _____ gpm
 Est. Yield **1.2 GPM** Well water was _____ ft. after _____ hours pumping _____ gpm
 Bore Hole Diameter: **7.25** in. to **80.5** ft., and _____ in. to _____ ft.
 WELL WATER TO BE USED AS:
 5 Public water supply 8 Air conditioning 11 Injection well
 1 Domestic 3 Feedlot 6 Oil field water supply 9 Dewatering 12 Other (Specify below)
 2 Irrigation 4 Industrial 7 Lawn and garden only 10 Monitoring well
 Was a chemical/bacteriological sample submitted to Department? Yes _____ No _____; If yes, mo/day/yr sample was submitted _____
 Water Well Disinfected? Yes _____ No **X**

5 TYPE OF BLANK CASING USED:
 1 Steel 3 RMP (SR) 5 Wrought iron 8 Concrete tile CASING JOINTS: Glued _____ Clamped _____
 2 PVC 4 ABS 6 Asbestos-Cement 9 Other (specify below) Welded _____
 7 Fiberglass _____ Threaded **X**
 Blank casing diameter: **2** in. to _____ ft., Dia. _____ in. to _____ ft., Dia. _____ in. to _____ ft.
 Casing height above land surface: **24** in., weight **SCH 40** lbs./ft. Wall thickness or gauge No. _____
 TYPE OF SCREEN OR PERFORATION MATERIAL:
 1 Steel 3 Stainless steel 5 Fiberglass 7 PVC 10 Asbestos-cement
 2 Brass 4 Galvanized steel 6 Concrete tile 8 RMP (SR) 11 Other (specify) _____
 9 ABS 12 None used (open hole)
 SCREEN OR PERFORATION OPENINGS ARE:
 1 Continuous slot 3 Mill slot 5 Gauzed wrapped 8 Saw cut 11 None (open hole)
 2 Louvered shutter 4 Key punched 6 Wire wrapped 9 Drilled holes
 7 Torch cut 10 Other (specify) _____
 SCREEN-PERFORATED INTERVALS: From **55.5** ft. to **80.5** ft., From _____ ft. to _____ ft.
 From _____ ft. to _____ ft., From _____ ft. to _____ ft.
SAND
GRAVEL PACK INTERVALS: From **53.2** ft. to **80.5** ft., From _____ ft. to _____ ft.
 From _____ ft. to _____ ft., From _____ ft. to _____ ft.

6 GROUT MATERIAL: 1 Neat cement 2 Cement grout 3 Bentonite 4 Other _____
 Grout Intervals: From **2.2** ft. to **53.2** ft., From _____ ft. to _____ ft., From _____ ft. to _____ ft.
 What is the nearest source of possible contamination:
 1 Septic tank 4 Lateral lines 7 Pit privy 10 Livestock pens 14 Abandoned water well
 2 Sewer lines 5 Cess pool 8 Sewage lagoon 11 Fuel storage 15 Oil well/Gas well
 3 Watertight sewer lines 6 Seepage pit 9 Feedyard 12 Fertilizer storage 16 Other (specify below)
 13 Insecticide storage **CONTAMINATED**
 Direction from well? _____ How many feet? **5 + W**

FROM	TO	LITHOLOGIC LOG	FROM	TO	PLUGGING INTERVALS
0	3	SILTY CLAY - SDY.			
3	5	SILTY CLAY - BR-TAN			
5	20	SILTY CLAY - TAN			
20	25	SANDY CLAY - DR. TAN			
25	26	CLAY SAND - BR-DAMP			
26	29	SAND			
29	45	SANDY CLAY			
45	55	SILTY CLAY			
55	61	SAND			
61	65.5	SILTY CLAY			
65.5	70	CALCHI BR-TAN			
70	75	SANDY CLAY - WH-TAN - CAL. FRAG.			
75	80.5	CLAY SAND - SCL FRAG - SAND			

7 CONTRACTOR'S OR LANDOWNER'S CERTIFICATION: This water well was (1) constructed, (2) reconstructed, or (3) plugged under my jurisdiction and was completed on (mo/day/year) **09-21-92** and this record is true to the best of my knowledge and belief. Kansas Water Well Contractor's License No. **479** This Water Well Record was completed on (mo/day/yr) **11-02-92** under the business name of **EBBERTS DRILLING** by (signature) *Arayan Ebbert*

OFFICE USE ONLY

T

R

EW

SEC.

1/4

1/4

1/4