


1 LOCATION OF WATER WELL: Fraction **NE 1/4 NW 1/4 SE 1/4** Section Number **5** Township Number **T 12 S** Range Number **R 25 EW**
 County: **TREGO**

Distance and direction from nearest town or city street address of well if located within city?
BLOCK 22. AINSLIE AVE COLLYER AVE

2 WATER WELL OWNER: **TREGO COUNTY HIGHWAY DEPT. 120 S MAIN - WAKEENY KS-67672**
 RR#, St. Address, Box #: **GEORGE OTTOI** Board of Agriculture, Division of Water Resources
 City, State, ZIP Code: Application Number:

3 LOCATE WELL'S LOCATION WITH AN "X" IN SECTION BOX:

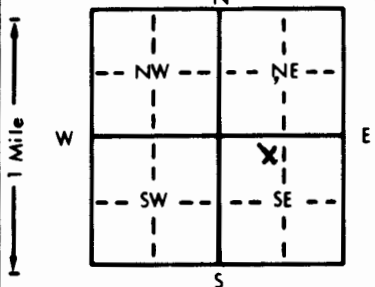

4 DEPTH OF COMPLETED WELL: **80.7** ft. ELEVATION: **2508.66**

Depth(s) Groundwater Encountered 1. **70.1** ft. 2. **-** ft. 3. **-** ft.
 WELL'S STATIC WATER LEVEL **73.02** ft. below land surface measured on mo/day/yr **10-02-92**
 Pump test data: Well water was **NA** ft. after **-** hours pumping **-** gpm
 Est. Yield **NA** gpm: Well water was **-** ft. after **-** hours pumping **-** gpm
 Bore Hole Diameter **7.25** in. to **80.7** ft. and **-** in. to **-** ft.
 WELL WATER TO BE USED AS:
 5 Public water supply 8 Air conditioning 11 Injection well
 1 Domestic 3 Feedlot 6 Oil field water supply 9 Dewatering 12 Other (Specify below)
 2 Irrigation 4 Industrial 7 Lawn and garden only **10 Monitoring well**
 Was a chemical/bacteriological sample submitted to Department? Yes **-** No **X**; If yes, mo/day/yr sample was submitted **-**
 Water Well Disinfected? Yes **-** No **X**

5 TYPE OF BLANK CASING USED:
 1 Steel 3 RMP (SR) 5 Wrought iron 8 Concrete tile CASING JOINTS: Glued **-** Clamped **-**
2 PVC 4 ABS 6 Asbestos-Cement 9 Other (specify below) Welded **-**
 7 Fiberglass Threaded **-**

Blank casing diameter **2** in. to **55.7** ft. Dia **-** in. to **-** ft. Dia **-** in. to **-** ft.
 Casing height above land surface **-** in. weight **5.4 40** lbs./ft. Wall thickness or gauge No. **-**

TYPE OF SCREEN OR PERFORATION MATERIAL:
 1 Steel 3 Stainless steel 5 Fiberglass 7 PVC 10 Asbestos-cement
 2 Brass 4 Galvanized steel 6 Concrete tile 8 RMP (SR) 11 Other (specify) **-**
 9 ABS 12 None used (open hole)

SCREEN OR PERFORATION OPENINGS ARE:
 1 Continuous slot 3 Mill slot 5 Gauzed wrapped 8 Saw cut 11 None (open hole)
 2 Louvered shutter 4 Key punched 6 Wire wrapped 9 Drilled holes
 7 Torch cut 10 Other (specify) **-**

SCREEN-PERFORATED INTERVALS: From **55.7** ft. to **80.7** ft. From **-** ft. to **-** ft.
 From **-** ft. to **-** ft. From **-** ft. to **-** ft.
 GRAVEL PACK INTERVALS: From **48.4** ft. to **80** ft. From **-** ft. to **-** ft.
 From **-** ft. to **-** ft. From **-** ft. to **-** ft.

6 GROUT MATERIAL: 1 Neat cement 2 Cement grout 3 Bentonite 4 Other **-**
 Grout Intervals: From **1.5** ft. to **48.4** ft. From **-** ft. to **-** ft. From **-** ft. to **-** ft.

What is the nearest source of possible contamination:
 1 Septic tank 4 Lateral lines 7 Pit privy 10 Livestock pens 14 Abandoned water well
 2 Sewer lines 5 Cess pool 8 Sewage lagoon 11 Fuel storage 15 Oil well/Gas well
 3 Watertight sewer lines 6 Seepage pit 9 Feedyard 12 Fertilizer storage 16 Other (specify below)
CONTAMINATED WATER + SOIL
 Direction from well? How many feet?

FROM	TO	LITHOLOGIC LOG	FROM	TO	PLUGGING INTERVALS
0	3	SILTY CLAY - DR GRV - TAN			
3	14	SILTY CLAY - BR - TAN			
14	25	SILTY CLAY - SCT SAND			
25	30	CLAYEY SAND - SCT GRAVEL			
30	35	CLAY SAND MOTTLED BR.			
35	40	SILTY CLAY SCT SAND			
40	45	CLAY SD - WEATHERED CHALECHI			
45	51	CLAY SD TAN			
51	55	SAND			
55	70	SILTY CLAY - BR - TAN - CGL. FRAG.			
70	74	SANDY CLAY - SAND			
74	80.7	CHALECHI - HARD			

7 CONTRACTOR'S OR LANDOWNER'S CERTIFICATION: This water well was (1) constructed, (2) reconstructed, or (3) plugged under my jurisdiction and was completed on (mo/day/year) **09-15-92** and this record is true to the best of my knowledge and belief. Kansas Water Well Contractor's License No. **479** This Water Well Record was completed on (mo/day/yr) **11-02-92** under the business name of **EBBERTS DRILLING** by (signature) *Susan Ebbert*

OFFICE USE ONLY