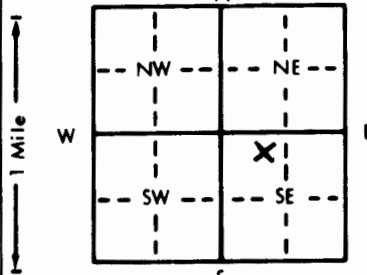


1 LOCATION OF WATER WELL: Fraction NE 1/4 NW 1/4 SE 1/4 Section Number 5 Township Number T 12 S Range Number R 25 EW  
 County: TRECO

Distance and direction from nearest town or city street address of well if located within city?  
BLOCK 22 - AINSLIE AVE - COLLYERKS-

2 WATER WELL OWNER: TRECO COUNTY HIGHWAY DEPT. 120 S MAIN WAKEENY KS 67672  
 RR#, St. Address, Box #: GEORGE O'TOOL Board of Agriculture, Division of Water Resources  
 City, State, ZIP Code: Application Number:

3 LOCATE WELL'S LOCATION WITH AN "X" IN SECTION BOX:  


4 DEPTH OF COMPLETED WELL: 20 ft. ELEVATION: 2508.48  
 Depth(s) Groundwater Encountered 1. 75.65 ft. 2. - ft. 3. - ft.  
 WELL'S STATIC WATER LEVEL 73.56 ft. below land surface measured on mo/day/yr 10-02-92  
 Pump test data: Well water was NA ft. after - hours pumping - gpm  
 Est. Yield NA gpm: Well water was - ft. after - hours pumping - gpm  
 Bore Hole Diameter 7.25 in. to 80 ft., and - in. to - ft.  
 WELL WATER TO BE USED AS: 5 Public water supply 8 Air conditioning 11 Injection well  
 1 Domestic 3 Feedlot 6 Oil field water supply 9 Dewatering 12 Other (Specify below)  
 2 Irrigation 4 Industrial 7 Lawn and garden only 10 Monitoring well  
 Was a chemical/bacteriological sample submitted to Department? Yes - No X; If yes, mo/day/yr sample was submitted  
 Water Well Disinfected? Yes - No X

5 TYPE OF BLANK CASING USED: 5 Wrought iron 8 Concrete tile CASING JOINTS: Glued - Clamped -  
 1 Steel 3 RMP (SR) 6 Asbestos-Cement 9 Other (specify below) Welded -  
2 PVC 4 ABS 7 Fiberglass Threaded X  
 Blank casing diameter 2 in. to 55 ft., Dia - in. to - ft., Dia - in. to - ft.  
 Casing height above land surface 24 in., weight SC440 lbs./ft. Wall thickness or gauge No. -  
 TYPE OF SCREEN OR PERFORATION MATERIAL: 7 PVC 10 Asbestos-cement  
 1 Steel 3 Stainless steel 5 Fiberglass 8 RMP (SR) 11 Other (specify) -  
 2 Brass 4 Galvanized steel 6 Concrete tile 9 ABS 12 None used (open hole)  
 SCREEN OR PERFORATION OPENINGS ARE: 5 Gauzed wrapped 8 Saw cut 11 None (open hole)  
 1 Continuous slot 3 Mill slot 6 Wire wrapped 9 Drilled holes  
 2 Louvered shutter 4 Key punched 7 Torch cut 10 Other (specify) -  
 SCREEN-PERFORATED INTERVALS: From 55 ft. to 80 ft., From - ft. to - ft.  
 From - ft. to - ft., From - ft. to - ft.  
SAND GRAVEL PACK INTERVALS: From 52.8 ft. to 80 ft., From - ft. to - ft.  
 From - ft. to - ft., From - ft. to - ft.

6 GROUT MATERIAL: 1 Neat cement 2 Cement grout 3 Bentonite 4 Other -  
 Grout intervals: From 2.7 ft. to 52.8 ft., From - ft. to - ft., From - ft. to - ft.  
 What is the nearest source of possible contamination:  
 1 Septic tank 4 Lateral lines 7 Pit privy 10 Livestock pens 14 Abandoned water well  
 2 Sewer lines 5 Cess pool 8 Sewage lagoon 11 Fuel storage 15 Oil well/Gas well  
 3 Watertight sewer lines 6 Seepage pit 9 Feedyard 12 Fertilizer storage 16 Other (specify below)  
 Direction from well? - How many feet? CONTAMINATED SOIL + WATER

| FROM | TO   | LITHOLOGIC LOG                   | FROM | TO | PLUGGING INTERVALS |
|------|------|----------------------------------|------|----|--------------------|
| 0    | 2    | CLAYEY SD-GRAVEL - FILL          |      |    |                    |
| 2    | 20   | SILTY CLAY TAN                   |      |    |                    |
| 20   | 25   | SILTY CLAY - BR-TAN SCT. SD.     |      |    |                    |
| 25   | 26   | LALECHI                          |      |    |                    |
| 26   | 28   | SAND                             |      |    |                    |
| 28   | 45   | SILTY CLAY BR-TAN                |      |    |                    |
| 45   | 56   | SILTY CLAY - SCT SAND            |      |    |                    |
| 56   | 60   | CLAYEY SAND - SD - LEVEE         |      |    |                    |
| 60   | 62   | SAND                             |      |    |                    |
| 62   | 67   | SAND WITH CALECHI MODULES        |      |    |                    |
| 67   | 70   | SILTY CLAY - SD                  |      |    |                    |
|      |      | (69) SATURATED                   |      |    |                    |
| 70   | 72.4 | SANDY CLAY - SD - CALLECHI FRAC. |      |    |                    |
| 72.4 | 80   | CALECHI I                        |      |    |                    |

7 CONTRACTOR'S OR LANDOWNER'S CERTIFICATION: This water well was (1) constructed, (2) reconstructed, or (3) plugged under my jurisdiction and was completed on (mo/day/year) 09-09-92 and this record is true to the best of my knowledge and belief. Kansas Water Well Contractor's License No. 479 This Water Well Record was completed on (mo/day/yr) 11-02-92 under the business name of EBBERTS DRILLING by (signature) Deegan Ebber

OFFICE USE ONLY  
T  
R  
EW  
SEC  
1/4  
1/4  
1/4