


1 LOCATION OF WATER WELL: Fraction **NE 1/4 NW 1/4 SE 1/4** Section Number **S** Township Number **T 12 S** Range Number **R 25 E**
 County: **TREGO**

Distance and direction from nearest town or city street address of well if located within city?
W OF DIMSLIE AVE N 1/4 4TH

2 WATER WELL OWNER: **TREGO C.D. HIGHWAY DEPT - WAKNEEY KS 67672**
 RR#, St. Address, Box #: **(GEORGE D'TOOL)** Board of Agriculture, Division of Water Resources
 City, State, ZIP Code: Application Number:

3 LOCATE WELL'S LOCATION WITH AN "X" IN SECTION BOX:

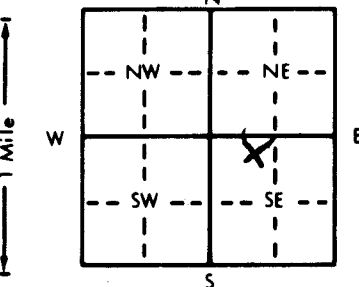

4 DEPTH OF COMPLETED WELL: **80** ft. ELEVATION: **-**
 Depth(s) Groundwater Encountered 1. **71** ft. 2. **-** ft. 3. **-** ft.
 WELL'S STATIC WATER LEVEL: **NA** ft. below land surface measured on mo/day/yr **-**
 Pump test data: Well water was **-** ft. after **-** hours pumping **-** gpm
 Est. Yield **NA** gpm: Well water was **-** ft. after **-** hours pumping **-** gpm
 Bore Hole Diameter: **7.25** in. to **80** ft., and **-** in. to **-** ft.
 WELL WATER TO BE USED AS:
 5 Public water supply 8 Air conditioning 11 Injection well
 1 Domestic 3 Feedlot 6 Oil field water supply 9 Dewatering 12 Other (Specify below)
 2 Irrigation 4 Industrial 7 Lawn and garden only 10 Monitoring well **SOIL BORING**
 Was a chemical/bacteriological sample submitted to Department? Yes **-** No **X**; If yes, mo/day/yr sample was submitted **-**
 Water Well Disinfected? Yes **-** No **X**

5 TYPE OF BLANK CASING USED:
 1 Steel 3 RMP (SR) 5 Wrought iron 8 Concrete tile CASING JOINTS: Glued **-** Clamped **-**
 2 PVC 4 ABS 6 Asbestos-Cement 9 Other (specify below) Welded **-**
 7 Fiberglass Threaded **-**
 Blank casing diameter **NA** in. to **-** ft., Dia. **-** in. to **-** ft., Dia. **-** in. to **-** ft.
 Casing height above land surface **NA** in., weight **-** lbs./ft. Wall thickness or gauge No. **-**
 TYPE OF SCREEN OR PERFORATION MATERIAL: **NA**
 1 Steel 3 Stainless steel 5 Fiberglass 8 RMP (SR) 10 Asbestos-cement
 2 Brass 4 Galvanized steel 6 Concrete tile 9 ABS 11 Other (specify) **-**
 12 None used (open hole)
 SCREEN OR PERFORATION OPENINGS ARE: **NA**
 1 Continuous slot 3 Mill slot 5 Gauzed wrapped 8 Saw cut 11 None (open hole)
 2 Louvered shutter 4 Key punched 7 Torch cut 9 Drilled holes 10 Other (specify) **-**
 SCREEN-PERFORATED INTERVALS: From **-** ft. to **-** ft., From **-** ft. to **-** ft., From **-** ft. to **-** ft.
SAND
GRAVEL PACK INTERVALS: From **66** ft. to **80** ft., From **-** ft. to **-** ft., From **-** ft. to **-** ft.

6 GROUT MATERIAL: 1 Neat cement 2 Cement grout 3 Bentonite 4 Other **-**
 Grout Intervals: From **3** ft. to **66** ft., From **-** ft. to **-** ft., From **-** ft. to **-** ft.
 What is the nearest source of possible contamination:
 1 Septic tank 4 Lateral lines 7 Pit privy 10 Livestock pens 14 Abandoned water well
 2 Sewer lines 5 Cess pool 8 Sewage lagoon 11 Fuel storage 15 Oil well/Gas well
 3 Watertight sewer lines 6 Seepage pit 9 Feedyard 12 Fertilizer storage 16 Other (specify below)
 13 Insecticide storage **CONTAMINATED**
 Direction from well? How many feet? **AREA - UNDETERMINED STORAGE**

FROM	TO	LITHOLOGIC LOG	FROM	TO	PLUGGING INTERVALS
0	4	SILTY CLAY SCT GRAVEL			
4	20	SILTY " - TAN			
20	26	SILTY " BR-TAN sct sd			
26	40	SILTY " BR-TAN			
40	45	CLAYEY SAND			
45	55	CLAYEY SD-BR-TAN			
55	60	SANDY CLAY-SCT SAND			
60	62	SAND-SCT GRAVEL			
62	70	SILTY CLAY-BR-TAN			
70	75.5	SANDY CLAY			
75.5	80	CALICHE			

7 CONTRACTOR'S OR LANDOWNER'S CERTIFICATION: This water well was (1) constructed, (2) reconstructed, or (3) plugged under my jurisdiction and was completed on (mo/day/year) **09-16-92** and this record is true to the best of my knowledge and belief. Kansas Water Well Contractor's License No. **479** This Water Well Record was completed on (mo/day/yr) **09-23-92** under the business name of **EBBERTS DRILLING** by (signature) *Arthur Ebberts*

OFFICE USE ONLY T R EW SEC. 1/4 1/4 1/4 1/4