


1) LOC/ ON OF WATER WELL: Fraction NE 1/4 NW 1/4 NW 1/4 Section Number 13 Township Number T 12 S Range Number R 25 E
 County: Trego
 Distance and direction from nearest town or city street address of well if located within city? 1.5 4E of Collyer

2) WATER WELL OWNER: MR. FRANK WALT
 RR#, St. Address, Box # :
 City, State, ZIP Code : COLLYER, KANSAS
 Board of Agriculture, Division of Water Resources
 Application Number:

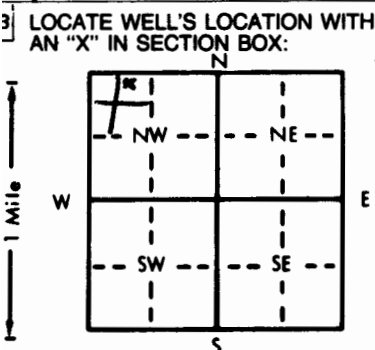

4) DEPTH OF COMPLETED WELL: 56 ft. ELEVATION:
 Depth(s) Groundwater Encountered 1. 40 ft. 2. ft. 3. ft.
 WELL'S STATIC WATER LEVEL 40 ft. below land surface measured on mo/day/yr
 Pump test data: Well water was ft. after hours pumping gpm
 Est. Yield 1.0 gpm: Well water was ft. after hours pumping gpm
 Bore Hole Diameter 9 in. to 56 ft., and in. to ft.
 WELL WATER TO BE USED AS:
 5 Public water supply 8 Air conditioning 11 Injection well
 1 Domestic 3 Feedlot 6 Oil field water supply 9 Dewatering 12 Other (Specify below)
 2 Irrigation 4 Industrial 7 Lawn and garden only 10 Observation well Stock well
 Was a chemical/bacteriological sample submitted to Department? Yes No X; if yes, mo/day/yr sample was submitted
 Water Well Disinfected? Yes X No

5) TYPE OF BLANK CASING USED:
 1 Steel 3 RMP (SR) 5 Wrought iron 8 Concrete tile CASING JOINTS: Glued X Clamped
 2 PVC 4 ABS 6 Asbestos-Cement 9 Other (specify below) Welded
 7 Fiberglass Threaded
 Blank casing diameter 5 in. to 46 ft., Dia in. to ft., Dia in. to ft.
 Casing height above land surface 12 in., weight 250 lbs./ft. Wall thickness or gauge No. 250
 TYPE OF SCREEN OR PERFORATION MATERIAL:
 1 Steel 3 Stainless steel 5 Fiberglass 7 PVC 10 Asbestos-cement
 2 Brass 4 Galvanized steel 6 Concrete tile 8 RMP (SR) 11 Other (specify)
 9 ABS 12 None used (open hole)
 SCREEN OR PERFORATION OPENINGS ARE:
 1 Continuous slot 3 Mill slot 5 Gauzed wrapped 8 Saw cut 11 None (open hole)
 2 Louvered shutter 4 Key punched 6 Wire wrapped 9 Drilled holes
 7 Torch cut 10 Other (specify)
 SCREEN-PERFORATED INTERVALS: From 46 ft. to 56 ft., From ft. to ft.
 From ft. to ft., From ft. to ft.
 GRAVEL PACK INTERVALS: From 40 ft. to 56 ft., From ft. to ft.
 From ft. to ft., From ft. to ft.

6) GROUT MATERIAL: 1 Neat cement 2 Cement grout 3 Bentonite 4 Other
 Grout Intervals: From 0 ft. to 10 ft., From ft. to ft., From ft. to ft.
 What is the nearest source of possible contamination:
 1 Septic tank 4 Lateral lines 7 Pit privy 11 Fuel storage 14 Abandoned water well
 2 Sewer lines 5 Cess pool 8 Sewage lagoon 12 Fertilizer storage 15 Oil well/Gas well
 3 Watertight sewer lines 6 Seepage pit 9 Feedyard 13 Insecticide storage Draw 16 Other (specify below)
 Direction from well? East How many feet? 500

FROM	TO	LITHOLOGIC LOG	FROM	TO	LITHOLOGIC LOG
0	15	Topsoil			
15	40	Sandy Clay			
40	54	Fine Sand			
54	56	Ochre			

7) CONTRACTOR'S OR LANDOWNER'S CERTIFICATION: This water well was (1) constructed, (2) reconstructed, or (3) plugged under my jurisdiction and was completed on (mo/day/year) 1-9-87 and this record is true to the best of my knowledge and belief. Kansas
 Water Well Contractor's License No. 376 This Water Well Record was completed on (mo/day/yr) 5-87
 under the business name of B & B DRILLING by (signature) Joseph Beberman

INSTRUCTIONS: Use typewriter or ball point pen. PLEASE PRESS FIRMLY and PRINT clearly. Please fill in blanks, underline or circle the correct answers. Send top three copies to Kansas Department of Health and Environment, Office of Oil Field and Environmental Geology, Regulation and Permitting Section, Topeka, Kansas 66620-7500, Telephone: 913-862-9360. Send one to WATER WELL OWNER and retain one for your records.

OFFICE USE ONLY