


1 LOCATION OF WATER WELL: County: <u>Trego</u>	Fraction <u>NE 1/4 SW 1/4 NW 1/4</u>	Section Number <u>30</u>	Township Number T <u>12</u> S	Range Number, R <u>25</u> EW
---	---	-----------------------------	----------------------------------	---------------------------------

Distance and direction from nearest town or city street address of well if located within city?
3 miles south + 1/2 west of Collyer + 1/2 south + 1/8 west of Collyer Kansas

2 WATER WELL OWNER:
 RR#, St. Address, Box # : John Stool
R 1 Collyer Kansas
 City, State, ZIP Code
 Board of Agriculture, Division of Water Resources
 Application Number:

3 LOCATE WELL'S LOCATION WITH AN "X" IN SECTION BOX:

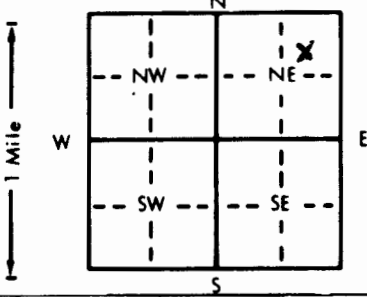

4 DEPTH OF COMPLETED WELL: 41 ft. ELEVATION:
 Depth(s) Groundwater Encountered 1. 14 ft. 2. 14 ft. 3. 14 ft.
 WELL'S STATIC WATER LEVEL 14 ft. below land surface measured on 12-10-91
 Pump test data: Well water was _____ ft. after _____ hours pumping _____ gpm
 Est. Yield 60 gpm: Well water was _____ ft. after _____ hours pumping _____ gpm
 Bore Hole Diameter 10 in. to 4 1/2 in. to _____ in. to _____ in.
 WELL WATER TO BE USED AS:
 Domestic Feedlot Oil field water supply Dewatering Other (Specify below)
 Irrigation Industrial Lawn and garden only Monitoring well
 Was a chemical/bacteriological sample submitted to Department? Yes _____ No If yes, mo/day/yr sample was submitted _____
 Water Well Disinfected? Yes _____ No

5 TYPE OF BLANK CASING USED:
 1 Steel 3 RMP (SR) 6 Asbestos-Cement 9 Other (specify below) Welded
 2 PVC 4 ABS 7 Fiberglass _____ Threaded

Blank casing diameter 2 1/2 in. to 2 1/2 ft., Dia. _____ in. to _____ ft., Dia. _____ in. to _____ ft.
 Casing height above land surface 30 in., weight 160 lbs./ft. Wall thickness or gauge No. _____

TYPE OF SCREEN OR PERFORATION MATERIAL:
 1 Steel 3 Stainless steel 5 Fiberglass 7 PVC 10 Asbestos-cement
 2 Brass 4 Galvanized steel 6 Concrete tile 9 ABS 11 Other (specify) _____
 12 None used (open hole)

SCREEN OR PERFORATION OPENINGS ARE:
 1 Continuous slot 3 Mill slot 8 Saw cut 11 None (open hole)
 2 Louvered shutter 4 Key punched 6 Wire wrapped 9 Drilled holes
 7 Torch cut 10 Other (specify) _____

SCREEN-PERFORATED INTERVALS: From _____ ft. to _____ ft., From _____ ft. to _____ ft.
 GRAVEL PACK INTERVALS: From 20 ft. to 41 ft., From _____ ft. to _____ ft.

6 GROUT MATERIAL: 1 Neat cement 2 Cement grout 3 Bentonite 4 Other _____
 Grout intervals: From 0 ft. to 20 ft., From _____ ft. to _____ ft., From _____ ft. to _____ ft.

What is the nearest source of possible contamination:
 1 Septic tank 4 Lateral lines 7 Pit privy 10 Livestock pens 14 Abandoned water well
 2 Sewer lines 5 Cess pool 8 Sewage lagoon 11 Fuel storage 15 Oil well/Gas well
 3 Watertight sewer lines 6 Seepage pit 9 Feedyard 12 Fertilizer storage 16 Other (specify below) _____
 13 Insecticide storage Big Creek

Direction from well? north How many feet? 200 feet

FROM	TO	LITHOLOGIC LOG	FROM	TO	PLUGGING INTERVALS
<u>0</u>	<u>5</u>	<u>Surface Clay</u>			
<u>5</u>	<u>15</u>	<u>Fine sand</u>			
<u>15</u>	<u>38</u>	<u>Large sand</u>			
<u>38</u>	<u>41</u>	<u>Blue mud</u>			

7 CONTRACTOR'S OR LANDOWNER'S CERTIFICATION: This water well was (1) constructed, (2) reconstructed, or (3) plugged under my jurisdiction and was completed on (mo/day/year) 12-10-91 and this record is true to the best of my knowledge and belief. Kansas Water Well Contractor's License No. 444 This Water Well Record was completed on (mo/day/yr) 12-10-91 under the business name of Anderson Drilling by (signature) Andy Anderson