


1 LOCATION OF WATER WELL: County: Lawe Fraction: NW 1/4 NW 1/4 NW 1/4 Section Number: 26 Township Number: T 12 S Range Number: R 26 E

Distance and direction from nearest town or city street address of well if located within city? 3065 W Quinter

2 WATER WELL OWNER: Frank Schwanenberger RR#, St. Address, Box #: Quinter, Ks 67752 Board of Agriculture, Division of Water Resources Application Number:

3 LOCATE WELL'S LOCATION WITH AN "X" IN SECTION BOX:

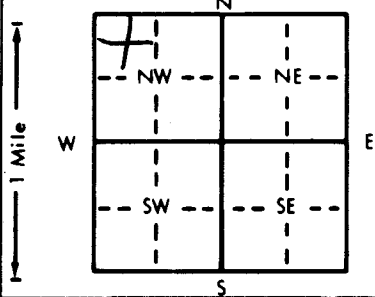

4 DEPTH OF COMPLETED WELL: 51 ft. ELEVATION: 45 ft. below land surface measured on mo/day/yr
 Depth(s) Groundwater Encountered 1. 45 ft. 2. 45 ft. 3. 45 ft.
 WELL'S STATIC WATER LEVEL: 45 ft. below land surface measured on mo/day/yr
 Pump test data: Well water was 5 gpm: Well water was 9 in. to 51 ft. after 5 hours pumping 5 gpm
 Est. Yield 5 gpm: Well water was 9 in. to 51 ft. after 5 hours pumping 5 gpm
 Bore Hole Diameter: 9 in. to 51 ft. and 51 in. to 51 ft.
 WELL WATER TO BE USED AS:
 1 Domestic 2 Irrigation 3 Feedlot 4 Industrial 5 Public water supply 6 Oil field water supply 7 Lawn and garden only 8 Air conditioning 9 Dewatering 10 Observation well 11 Injection well 12 Other (Specify below)
 Was a chemical/bacteriological sample submitted to Department? Yes X No X; If yes, mo/day/yr sample was submitted
 Water Well Disinfected? Yes X No X

5 TYPE OF BLANK CASING USED:
 1 Steel 3 RMP (SR) 5 Wrought iron 8 Concrete tile 9 Other (specify below)
 PVC 4 ABS 6 Asbestos-Cement 7 Fiberglass 10 Asbestos-cement

TYPE OF SCREEN OR PERFORATION MATERIAL:
 1 Steel 3 Stainless steel 5 Fiberglass 8 RMP (SR) 10 Asbestos-cement
 2 Brass 4 Galvanized steel 6 Concrete tile 9 ABS 11 Other (specify): 12 None used (open hole)
 SCREEN OR PERFORATION OPENINGS ARE:
 1 Continuous slot 3 Mill slot 5 Gauzed wrapped 6 Saw cut 11 None (open hole)
 2 Louvered shutter 4 Key punched 6 Wire wrapped 9 Drilled holes
 7 Torch cut 10 Other (specify):

SCREEN-PERFORATED INTERVALS: From 42 ft. to 51 ft. From 42 ft. to 51 ft. From 42 ft. to 51 ft.
 GRAVEL PACK INTERVALS: From 22 ft. to 51 ft. From 22 ft. to 51 ft. From 22 ft. to 51 ft.

6 GROUT MATERIAL: Neat cement 2 Cement grout 3 Bentonite 4 Other
 Grout intervals: From 0 ft. to 10 ft. From 0 ft. to 10 ft. From 0 ft. to 10 ft. From 0 ft. to 10 ft.

What is the nearest source of possible contamination:
 1 Septic tank 4 Lateral lines 7 Pit privy 10 Livestock pens 14 Abandoned water well
 2 Sewer lines 5 Cess pool 8 Sewage lagoon 11 Fuel storage 15 Oil well/Gas well
 3 Watertight sewer lines 6 Seepage pit 9 Feedyard 12 Fertilizer storage 16 Other (specify below): Drain
 13 Insecticide storage 16 Other (specify below): Drain
 Direction from well? 200 W How many feet? 200 W

FROM	TO	LITHOLOGIC LOG	FROM	TO	LITHOLOGIC LOG
0	3	Sandy Clay			
3	11	M. Shale			
11	48	Sandy Clay			
48	51	M. Shale			
51		Ochre			

7 CONTRACTOR'S OR LANDOWNER'S CERTIFICATION: This water well was constructed, (2) reconstructed, or (3) plugged under my jurisdiction and was completed on (mo/day/year) 5-81 and this record is true to the best of my knowledge and belief. Kansas Water Well Contractor's License No. 376 This Water Well Record was completed on (mo/day/year) 5-81 under the business name of B+B Drilling by (signature) Joseph B. Baker

INSTRUCTIONS: Use typewriter or ball point pen, PLEASE PRESS FIRMLY and PRINT clearly. Please fill in blanks, underline or circle the correct answers. Send top three copies to Kansas Department of Health and Environment, Division of Environment, Environmental Geology Section, Topeka, KS 66620. Send one to WATER WELL OWNER and retain one for your records.

OFFICE USE ONLY T 12 R 26 SEC. 26 NW 1/4 NW 1/4 NW 1/4