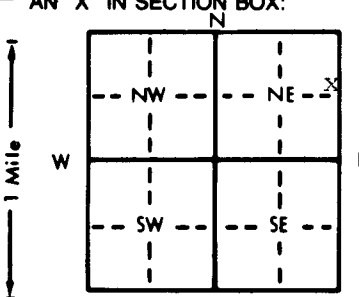


1 LOCATION OF WATER WELL: Fraction SE 1/4 NE 1/4 NE 1/4 Section Number 4 Township Number T 12 S Range Number R 27 W E/W
 County: Gove
 Distance and direction from nearest town or city street address of well if located within city?
N/A - LOCATION CONFIRMED BY GMD #4

2 WATER WELL OWNER: Marvin Sprengel
 RR#, St. Address, Box #: PO Box 206 Board of Agriculture, Division of Water Resources
 City, State, ZIP Code: Quinter, KS 67752 Application Number:

3 LOCATE WELL'S LOCATION WITH AN "X" IN SECTION BOX:

 4 DEPTH OF COMPLETED WELL: UNK. (52) ft. ELEVATION:
 Depth(s) Groundwater Encountered 1. _____ ft. 2. _____ ft. 3. _____ ft.
 WELL'S STATIC WATER LEVEL (32) ft. below land surface measured on mo/day/yr
 Pump test data: Well water was _____ ft. after _____ hours pumping _____ gpm
 Est. Yield _____ gpm: Well water was _____ ft. after _____ hours pumping _____ gpm
 Bore Hole Diameter _____ in. to _____ ft., and _____ in. to _____ ft.
 WELL WATER TO BE USED AS:
 Domestic 3 Feedlot 6 Oil field water supply 9 Dewatering 12 Other (Specify below)
 2 Irrigation 4 Industrial 7 Lawn and garden only 10 Monitoring well
 Was a chemical/bacteriological sample submitted to Department? Yes _____ No _____; If yes, mo/day/yr sample was submitted _____
 Water Well Disinfected? Yes _____ No _____

5 TYPE OF BLANK CASING USED:
 Steel 3 RMP (SR) 6 Asbestos-Cement 9 Other (specify below) Welded _____
 2 PVC 4 ABS 7 Fiberglass _____ Threaded _____
 Blank casing diameter _____ in. to _____ ft., Dia _____ in. to _____ ft., Dia _____ in. to _____ ft.
 Casing height above land surface _____ in., weight _____ lbs./ft. Wall thickness or gauge No. _____
 TYPE OF SCREEN OR PERFORATION MATERIAL:
 1 Steel 3 Stainless steel 5 Fiberglass 8 RMP (SR) 10 Asbestos-cement
 2 Brass 4 Galvanized steel 6 Concrete tile 9 ABS 11 Other (specify) _____
 12 None used (open hole)
 SCREEN OR PERFORATION OPENINGS ARE:
 1 Continuous slot 3 Mill slot 5 Gauzed wrapped 8 Saw cut 11 None (open hole)
 2 Louvered shutter 4 Key punched 6 Wire wrapped 9 Drilled holes
 7 Torch cut 10 Other (specify) _____
 SCREEN-PERFORATED INTERVALS: From _____ ft. to _____ ft., From _____ ft. to _____ ft., From _____ ft. to _____ ft.
 GRAVEL PACK INTERVALS: From _____ ft. to _____ ft., From _____ ft. to _____ ft., From _____ ft. to _____ ft.

6 GROUT MATERIAL: 1 Neat cement 2 Cement grout 3 Bentonite 4 Other _____
 Grout intervals: From 7 ft. to 4 ft., From _____ ft. to _____ ft., From _____ ft. to _____ ft.
 What is the nearest source of possible contamination:
 1 Septic tank 4 Lateral lines 7 Pit privy 10 Livestock pens 14 Abandoned water well
 2 Sewer lines 5 Cess pool 8 Sewage lagoon 11 Fuel storage 15 Oil well/Gas well
 3 Watertight sewer lines 6 Septic pit 9 Feedyard 12 Fertilizer storage 16 Other (specify below) NO N.E.
 13 Insecticide storage
 Direction from well? _____ How many feet? _____

FROM	TO	LITHOLOGIC LOG	FROM	TO	PLUGGING INTERVALS
		<u>AUG 14 1989</u>	<u>Friday</u>	<u>July 28, 1989.</u>	<u>To-day we pulled the pipe and pump then took the tower down on the water well listed above and at the above location.</u>
	<u>ENTER</u>				
		<u>DIVISION OF ENVIRONMENT</u>			
		<u>PLUGGING</u>			<u>We then proceeded to put clean sand into the well casing until we were at the top of the water level (approximately 20 feet) then we poured one gallon of chlorox into the hole. We then put dirt into the hole and then some more clean sand. We put approximately 20 feet of dirt into the hole then about 5 more feet of sand.</u>
<u>52</u>	<u>32</u>	<u>SAND INFORMATION</u>			
<u>32</u>	<u>12</u>	<u>CLAY</u>			
<u>12</u>	<u>7</u>	<u>SAND</u>			
<u>7</u>	<u>4</u>	<u>CEMENT AT</u>			
<u>4</u>	<u>0</u>	<u>SURFACE CLAY</u>			
		<u>RIGHT</u>			<u>We then mixed cement at a six to one mixture and finished filling the casing. The thickness of cement was over 36 inches. The length of a shovel handel. All of this is covered about 4 feet.</u>

7 CONTRACTOR'S OR LANDOWNER'S CERTIFICATION: This water well was (1) constructed, (2) reconstructed, or (3) plugged under my jurisdiction and was completed on (mo/day/year) July 28, 1989 and this record is true to the best of my knowledge and belief. Kansas Water Well Contractor's License No. _____ This Water Well Record was completed on (mo/day/yr) _____ under the business name of _____ by (signature) Marvin Sprengel

When I say above that all of this is covered about four feet, I am saying that we dug a hole at least four feet deep and removed the casing that far down. Merton Ikenberry farms the land for me and he stated that it had to be that deep so he would be able to use a rapper and not have to worry about hitting the plug. So that is what we did. Marvin Sprengel

OFFICE USE ONLY
T
R
EW
SEC.