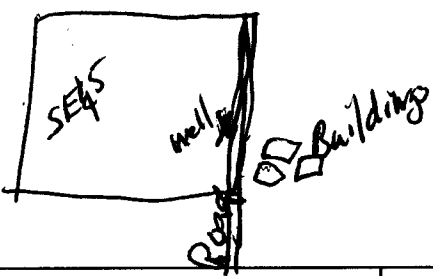


USE TYPEWRITER OR BALL POINT PEN-PRESS FIRMLY, PRINT CLEARLY.

WATER WELL RECORD  
KSA 82a-1201-1215

Kansas Department of Health and Environment-Division of Environment  
(Water well Contractors)  
Topeka, Kansas 66620

1. Location of well:		County <b>Gove</b>	Fraction <b>NE 1/4 SE 1/4 SE 1/4</b>	Section number <b>5</b>	Township number <b>T 12 S</b>	Range number <b>R 27 E</b>	<b>DRL</b>
2. Distance and direction from nearest town or city: Street address of well location if in city:			3. Owner of well: <b>Leo Norton</b> R.R. or street: <b>Park, Kansas 67751</b> City, state, zip code:				
4. Locate with "X" in section below: N W E S 1 Mile			Sketch map: 		6. Bore hole dia. <b>19</b> in. Completion date _____ Well depth <b>108</b> ft. <b>5/19/77</b>		
5. Type and color of material			From	To	7. <input type="checkbox"/> Cable tool <input type="checkbox"/> Rotary <input type="checkbox"/> Driven <input type="checkbox"/> Dug <input type="checkbox"/> Hollow rod <input type="checkbox"/> Jetted <input type="checkbox"/> Bored <input checked="" type="checkbox"/> Reverse rotary		
silt + clay			0	30	8. Use: <input type="checkbox"/> Domestic <input type="checkbox"/> Public supply <input type="checkbox"/> Industry <input checked="" type="checkbox"/> Irrigation <input type="checkbox"/> Air conditioning <input type="checkbox"/> Stock <input type="checkbox"/> Lawn <input type="checkbox"/> Oil field water <input type="checkbox"/> Other		
gravel			30	55	9. Casing: Material <b>CEAS</b> Height: <b>above</b> or below Threaded <input type="checkbox"/> Welded <input checked="" type="checkbox"/> <b>clamp</b> Surface <b>12</b> in. RMP _____ PVC _____ Weight _____ lbs./ft. Dia. <b>12</b> in. to <b>108</b> ft. depth Wall Thickness: inches or Dia. _____ in. to _____ ft. depth gage No. _____		
stone + Rocky sand			55	60	10. Screen: Manufacturer's name _____ <b>Johnson Well Casing</b> Type <b>cement asbest</b> ea. <b>12</b> in. Slot/gauze <b>1/4</b> Length <b>20</b> ft. Set between <b>56</b> ft. and <b>108</b> ft. ft. and _____ ft. Gravel pack? <input checked="" type="checkbox"/> Size range of material <b>1</b> down		
gravel - little clay			60	108	11. Static water level: <b>40</b> ft. below land surface Date <b>5/19/77</b> mo./day/yr.		
shale			108		12. Pumping level below land surfaces: _____ ft. after _____ hrs. pumping _____ g.p.m. _____ ft. after _____ hrs. pumping _____ g.p.m. Estimated maximum yield <b>600</b> g.p.m.		
					13. Water sample submitted: _____ mo./day/yr. Yes <input type="checkbox"/> No <input checked="" type="checkbox"/> Date _____		
					14. Well head completion: <input type="checkbox"/> Pitless adapter _____ Inches above grade		
					15. Well grouted? <input checked="" type="checkbox"/> <b>cement slab</b> With: <input type="checkbox"/> Neat cement <input type="checkbox"/> Bentonite <input type="checkbox"/> Concrete Depth: From <b>0</b> ft. to <b>5</b> ft.		
					16. Nearest source of possible contamination: ft. _____ Direction _____ Type _____ Well disinfected upon completion? Yes <input type="checkbox"/> No <input checked="" type="checkbox"/>		
					17. Pump: <input checked="" type="checkbox"/> Not installed Manufacturer's name _____ Model number _____ HP _____ Volts _____ Length of drop pipe _____ ft. capacity _____ g.p.m. Type: <input type="checkbox"/> Submersible <input type="checkbox"/> Turbine <input type="checkbox"/> Jet <input type="checkbox"/> Reciprocating <input type="checkbox"/> Centrifugal <input type="checkbox"/> Other		
					20. Water well contractor's certification: This well was drilled under my jurisdiction and this report is true to the best of my knowledge and belief. <b>Aqua Well Drilling 281</b> Business name License No. _____ Address <b>Gove, Ks. 67736</b> Signed <b>Jm Little</b> Date <b>6-20</b> Authorized representative		
18. Elevation:		19. Remarks:		(Use a second sheet if needed)			
Topography: <input type="checkbox"/> Hill <input checked="" type="checkbox"/> Slope <input checked="" type="checkbox"/> Upland <input type="checkbox"/> Valley							

Forward the white, blue and pink copies to the Department of Health and Environment


Form WWC-5

# Agua Well Drilling

## LOG OF EXPLORATORY HOLE

Footage 625' JOB NO. 4# JOB NAME Las Mesas DATE March 23  
 HOLE NO. 4# HOLE ELEVATION \_\_\_\_\_ DRILLER Jansory  
 HOLE LOCATION South West of Quarter

DEPTH		SOIL SYMBOL	SOIL DESCRIPTION
FROM	TO		
4# 30	55	gravel	1. 98-90 shale
55	58	stone	2. 96-100 stone shale
58	103	gravel	3. 100-105 stone shale
+		2 stone	5. 105-105 yellow
		3 clay	6. 108-108 yellow
103	112	stone	stone yellow 104-100 shale
112	115	shale	
			N

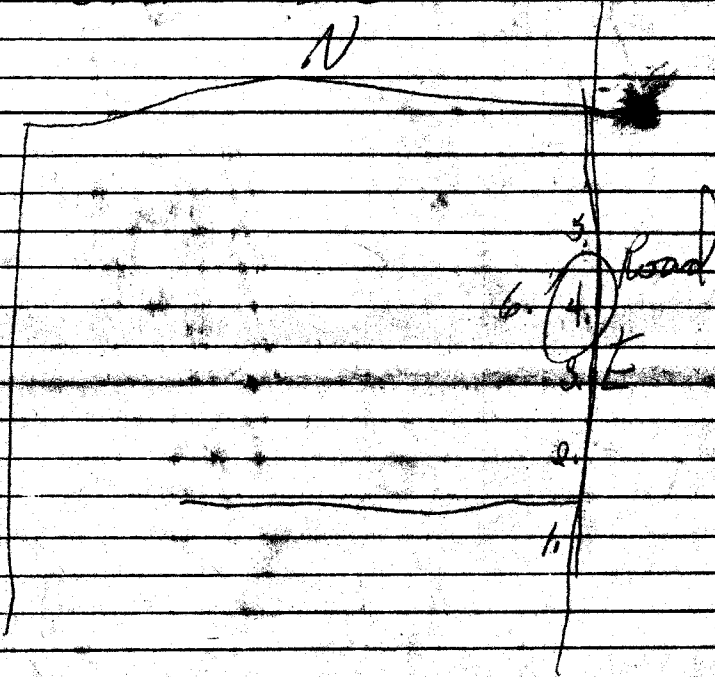

625'  
 60'  
 # B 95.00

	MOISTURE					HARDNESS			GRADING				COLOR	BEDROCK			CONDITION				OTHER	
	DRY	MOIST	WET	SOFT	FIRM	HARD	% SAND	% GRAVEL	% FINES (-200)	FINE	MEDIUM	COARSE		GRAVEL	CLAYSTONE	SILTSTONE	CONCRETE	MASSIVE	FRAT.	FRACURED		POROUS

DEPTH TO BEDROCK \_\_\_\_\_ DEPTH TO WATER TABLE \_\_\_\_\_