

1	LOCATION OF WATER WELL:	Fraction	Section Number	Township Number	Range Number
	County: <u>Gove</u>	<u>SW 1/4 SW 1/4 NE 1/4</u>	<u>25</u>	<u>T 12 S</u>	<u>R 28 E/W</u>

Distance and direction from nearest town or city street address of well if located within city?

2	WATER WELL OWNER:
---	-------------------


RR#, St. Address, Box # : 8080 Cord U
City, State, ZIP Code : Quinter, KS 67752

Board of Agriculture, Division of Water Resources
Application Number:

3 LOCATE WELL'S LOCATION WITH

4 DEPTH OF COMPLETED WELL 58 ft. ELEVATION:

AN "X" IN SECTION BOX:

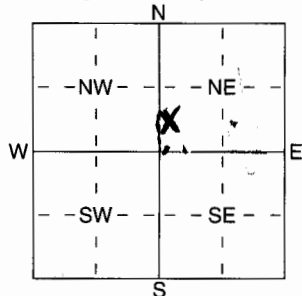

Depth(s) Groundwater Encountered: 21 ft. 2 _____ ft. 3 _____ ft.
WELL'S STATIC WATER LEVEL 21 ft. below land surface measured on mo/day/yr _____
Pump test data: Well water was _____ ft. after _____ hours pumping _____ gpm
Est. Yield 20 gpm: Well water was _____ ft. after _____ hours pumping _____ gpm
WELL WATER TO BE USED AS:

1 Domestic	3 Feedlot	5 Public water supply	8 Air conditioning	11 Injection well
2 Irrigation	4 Industrial	6 Oil field water supply	9 Dewatering	12 Other (Specify below)
		7 Domestic (lawn & garden)	10 Monitoring well	

Was a chemical/bacteriological sample submitted to Department? Yes No ; If yes, mo/day/yr sample was submitted

5	TYPE OF BLANK CASING USED:
---	----------------------------

5 Wrought iron

8 Concrete tile

CASING JOINTS: Glued Clamped

1 Steel
2 PVC
3 RMP (SR)
4 ABS

6 Asbestos-Cement
7 Fiberglass

9 Other (specify below)

Welded

Threaded

Blank casing diameter 5 in. to 48 ft, Dia in. to ft, Dia in. to ft.
Casing height above land surface 24 in., weight 160 lbs./ft. Wall thickness or gauge No. SDR 26

TYPE OF SCREEN OR PERFORATION MATERIAL:

1 Steel	3 Stainless Steel
2 Brass	4 Galvanized Steel

5 Fiberglass
6 Concrete tile

7 PVC

10 Asbestos-Cement

11 Other (Specify)

12 None used (open hole)

SCREEN OR PERFORATION OPENINGS ARE:

1 Continuous slot 3 Mill slot
2 Louvered shutter 4 Key punched

5 Guazed wrapped
6 Wire wrapped
7 Torch cut

8 Saw cut
9 Drilled holes
10 Other (specify)ft.
11 None (open hole)

SCREEN-PERFORATED INTERVALS: From 40 ft. to 58 ft., From _____ ft. to _____ ft.
From _____ ft. to _____ ft., From _____ ft. to _____ ft.

GRAVEL PACK INTERVALS: From 40 ft. to 58 ft., From _____ ft. to _____ ft.
From _____ ft. to _____ ft., From _____ ft. to _____ ft.

6	GROUT MATERIAL:
---	-----------------

1 Neat cement

2 Cement grout

3 Bentonite

4 Other

Grout Intervals: From 0 ft. to 2 ft., From 2 ft. to 3 ft., From 3 ft. to 4 ft.

What is the nearest source of possible contamination:

1 Septic tank	4 Lateral lines
2 Sewer lines	5 Cess pool
3 Watertight sewer lines	6 Seepage pit

7 Pit privy
8 Sewage lagoon
9 Feedyard

10 Livestock pens	14 Abandoned water well
11 Fuel storage	15 Oil well/Gas well
12 Fertilizer storage	16 Other (specify below)
13 Insecticide storage	

Direction from well?

How many feet?

none

FROM	TO	LITHOLOGIC LOG	FROM	TO	PLUGGING INTERVALS
0	2	Topsoil			
2	28	sand			
28	42	sand w/ brown clay			
42	57	coarse sand			
57	58	shale			

7. CONTRACTOR'S OR LANDOWNER'S CERTIFICATION: This water well was (1) constructed, (2) reconstructed, or (3) plugged under my jurisdiction and was completed on (mo/day/year) 9-22-04 and this record is true to the best of my knowledge and belief. Kansas Water Well Contractor's Licence No. 489 This Water Well Record was completed on (mo/day/yr) 10-7-06 under the business name of AGUA DUMA by (signature) [Signature]