

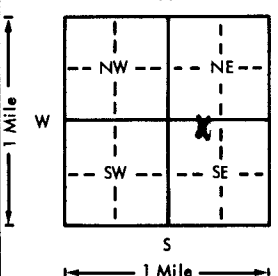
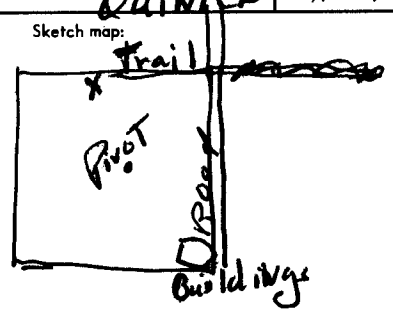
USE TYPEWRITER OR BALL
POINT PEN-PRESS FIRMLY,
PRINT CLEARLY.

Wilford Jamison

WATER WELL RECORD
KSA 82a-1201-1215

Kansas Department of Health and
Environment-Division of Environment
(Water well Contractors)
Topeka, Kansas 66620

Location

X Location of well:		County Gove	Fraction NE 1/4 NW 1/4 SE 1/4	Section number 5	Township number T 12 S	Range number R 28
X Distance and direction from nearest town or city: Street address of well location if in city:		3. Owner of well: Gretta Jamison R.R. or street: City, state, zip code: Quinter, Kansas				
4. Locate with "X" in section below: 		Sketch map: 		6. Bore hole dia. 19 in. Completion date 12/30/76 Well depth 153 ft.		
5. Type and color of material		From		To		7. <input type="checkbox"/> Cable tool <input checked="" type="checkbox"/> Rotary <input type="checkbox"/> Driven <input type="checkbox"/> Dug <input type="checkbox"/> Hollow rod <input type="checkbox"/> Jetted <input type="checkbox"/> Bored <input checked="" type="checkbox"/> Reverse rotary
Silt + clay		0		60		8. Use: <input type="checkbox"/> Domestic <input type="checkbox"/> Public supply <input type="checkbox"/> Industry <input checked="" type="checkbox"/> Irrigation <input type="checkbox"/> Air conditioning <input type="checkbox"/> Stock <input type="checkbox"/> Lawn <input type="checkbox"/> Oil field water <input type="checkbox"/> Other
Sandstone + clay		60		105		9. Casing: Material CEAS Height: Above or below Threaded <input type="checkbox"/> Welded <input checked="" type="checkbox"/> Surface 12 in. RMP <input type="checkbox"/> PVC <input type="checkbox"/> Weight <input type="checkbox"/> lbs./ft. Dia. 12 in. to 153 ft. depth Wall Thickness: inches or Dig. <input type="checkbox"/> in. to <input type="checkbox"/> ft. depth Gage No. <input type="checkbox"/>
Sand gravel Rock layers		105		130		10. Screen: Manufacturer's name Johnson Casing Co. Type Cement asbestos Dia. 12 in. Slot/gauze 1/4 Length 13 ft. Set between 99 ft. and 153 ft. ft. and <input type="checkbox"/> ft. Gravel pack? <input checked="" type="checkbox"/> Size range of material 1/4 down
gravel with some						11. Static water level: <input type="checkbox"/> mo./day/yr. 69 ft. below land surface Date 12/30/76
clay		130		153		12. Pumping level below land surfaces: ft. after <input type="checkbox"/> hrs. pumping <input type="checkbox"/> g.p.m. ft. after <input type="checkbox"/> hrs. pumping <input type="checkbox"/> g.p.m. Estimated maximum yield 500 g.p.m.
yellow clay		153				13. Water sample submitted: <input type="checkbox"/> mo./day/yr. Yes <input checked="" type="checkbox"/> No <input type="checkbox"/> Date <input type="checkbox"/>
						14. Well head completion: <input type="checkbox"/> Pitless adapter <input type="checkbox"/> inches above grade
						15. Well grouted? yes CEMENT SLAB With: <input type="checkbox"/> Neat cement <input type="checkbox"/> Bentonite <input checked="" type="checkbox"/> Concrete Depth: From 0 ft. to 5 ft.
						16. Nearest source of possible contamination: ft. <input type="checkbox"/> Direction <input type="checkbox"/> Type <input type="checkbox"/> Well disinfected upon completion? <input type="checkbox"/> Yes <input type="checkbox"/> No
						17. Pump: <input checked="" type="checkbox"/> Not installed Manufacturer's name <input type="checkbox"/> Model number <input type="checkbox"/> HP <input type="checkbox"/> Volts <input type="checkbox"/> Length of drop pipe <input type="checkbox"/> ft. capacity <input type="checkbox"/> g.p.m. Type: <input type="checkbox"/> Submersible <input type="checkbox"/> Turbine <input type="checkbox"/> Jet <input type="checkbox"/> Reciprocating <input type="checkbox"/> Centrifugal <input type="checkbox"/> Other
18. Elevation:		19. Remarks:		20. Water well contractor's certification: This well was drilled under my jurisdiction and this report is true to the best of my knowledge and belief. Aqua Well Drilling 281 Business name Gove, Kansas 67736 License No. 6-20 Address 7 M. Little Date 12/30/76 Signed 77 Authorized representative		