USE TYPEWRITER OR BALL POINT PEN-PRESS FIRMLY, PRINT CLEARLY.

WATER WELL RECORD
KSA 82a-1201-1215

Kansas Department of Health and Environment-Division of Environment
(Water well Contractors)
Topeka, Kansas 66620

DRL

1. Location of well:	County	Fraction	Section number	Township number	Range number
	Gove	Sw 1/4 SW 1/4 NE 1/4	30	T 12 S	R 29 E/W

2. Distance and direction from nearest town or city: 4½ west 1½ north of Gove
Street address of well location if in city:

3. Owner of well: Clem A.J. Zerr
R.R. or street:
City, state, zip code: Grinnell, Ks.

4. Locate with "X" in section below:

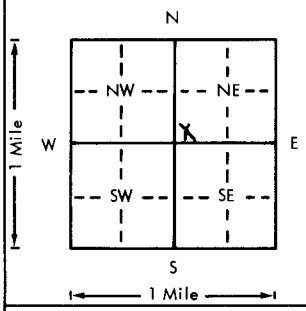

Sketch map:

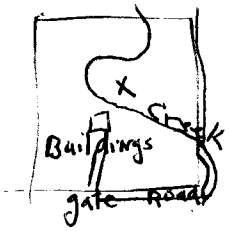

6. Bore hole dia. 19 in. Completion date 5/6/76
Well depth 51 ft.

7. __ Cable tool X Rotary __ Driven __ Dug
__ Hollow rod __ Jetted __ Bored X Reverse rotary

8. Use: __ Domestic __ Public supply __ Industry
X Irrigation __ Air conditioning __ Stock
__ Lawn __ Oil field water __ Other

X 9. Casing: Material CeAs clamp Height: Above or below
Threaded ___ Welded ___ Surface 12 in.
RMP ___ PVC ___ Weight ___ lbs./ft.
Dia. 12 in. to 51 ft. depth Wall Thickness: inches or
Dia. ___ in. to ___ ft. depth gage No.

X 10. Screen: Manufacturer's name Johnson Well Casing
Type cement asbestos Dia. 12 in.
Slot/gauze 3/16 Length 13 ft.
Set between 22 ft. and 51 ft.
___ ft. and ___ ft.
Gravel pack? X Size range of material ½ down

11. Static water level:
20 ft. below land surface Date 5/6/76 mo./day/yr.

12. Pumping level below land surfaces:
___ ft. after ___ hrs. pumping ___ g.p.m.
___ ft. after ___ hrs. pumping ___ g.p.m.
Estimated maximum yield 200 g.p.m.

13. Water sample submitted: mo./day/yr.
___ Yes X No Date

14. Well head completion:
___ Pitless adapter ___ Inches above grade

X 15. Well grouted? cement slab
With: ___ Neat cement ___ Bentonite ___ Concrete
Depth: From ___ ft. to ___ ft.

X 16. Nearest source of possible contamination:
ft. ___ Direction ___ Type ___
Well disinfected upon completion? ___ Yes ___ No

17. Pump: X Not installed
Manufacturer's name
Model number ___ HP ___ Volts ___
Length of drop pipe ___ ft. capacity ___ g.p.m.
Type:
___ Submersible ___ Turbine
___ Jet ___ Reciprocating
___ Centrifugal ___ Other

5. Type and color of material

	From	To
silt + clay	0	22
clay + sand	22	35
sand + gravel	35	51
shale		

(Use a second sheet if needed)

T ___ R ___ E/W ___ Sec ___ 1/4 ___ 1/4 ___ 1/4 ___

18. Elevation:

Topography:
___ Hill
___ Slope
___ Upland
X Valley

19. Remarks:

20. Water well contractor's certification:
This well was drilled under my jurisdiction and this report is true to the best of my knowledge and belief.
Aqua Well Drilling 281
Business name License No.
Address Gove, Ks. 67736
Signed M Tuttle Date 6-30-77
Authorized representative

Forward the white, blue and pink copies to the Department of Health and Environment

Form WWC-5

MI-1023