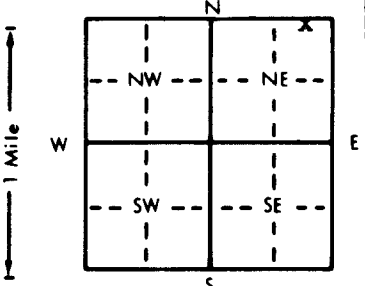


1 LOCATION OF WATER WELL: Fraction NE 1/4 NE 1/4 NE 1/4 Section Number 24 Township Number T 12 S Range Number R 3 E/W
 County: OTTAWA

Distance and direction from nearest town or city street address of well if located within city?
1/8 MILE WEST OF INTERSECTION CORONADO RD. AND 180th RD. SOUTH SIDE OTTAWA COUNTY PERMIT #99-208

2 WATER WELL OWNER: MARK CORRELL
 RR#, St. Address, Box # : 2825 W. STATE ST. Board of Agriculture, Division of Water Resources
 City, State, ZIP Code : SALINA, KS. 67401 Application Number:

3 LOCATE WELL'S LOCATION WITH AN "X" IN SECTION BOX:

 4 DEPTH OF COMPLETED WELL: 65.8 ft. ELEVATION:
 Depth(s) Groundwater Encountered 1. 23.8 ft. 2. ft. 3. ft.
 WELL'S STATIC WATER LEVEL 23.8 ft. below land surface measured on mo/day/yr 5-25-99
 Pump test data: Well water was 39 ft. after 2 hours pumping 20 gpm
 Est. Yield 30 gpm: Well water was 66 ft. after 20 hours pumping 20 gpm
 Bore Hole Diameter: 9 in. to 66 in. to ft. and in. to ft.
 WELL WATER TO BE USED AS: 5 Public water supply 8 Air conditioning 11 Injection well
1 Domestic 3 Feedlot 6 Oil field water supply 9 Dewatering 12 Other (Specify below)
 2 Irrigation 4 Industrial 7 Lawn and garden only 10 Monitoring well
 Was a chemical/bacteriological sample submitted to Department? Yes.....No...X.....; If yes, mo/day/yr sample was submitted
 Water Well Disinfected? Yes X No

5 TYPE OF BLANK CASING USED:
 1 Steel 3 RMP (SR) 5 Wrought iron 8 Concrete tile CASING JOINTS: Glued X Clamped
2 PVC 4 ABS 6 Asbestos-Cement 9 Other (specify below) Welded
 7 Fiberglass Threaded
 Blank casing diameter 5 in. to 55.8 ft., Dia. in. to ft., Dia. in. to ft.
 Casing height above land surface 24 in., weight 160 lbs./ft. Wall thickness or gauge No. SDR 26
 TYPE OF SCREEN OR PERFORATION MATERIAL:
 1 Steel 3 Stainless steel 5 Fiberglass 7 PVC 8 RMP (SR) 10 Asbestos-cement
 2 Brass 4 Galvanized steel 6 Concrete tile 9 ABS 11 Other (specify)
 12 None used (open hole)
 SCREEN OR PERFORATION OPENINGS ARE:
 1 Continuous slot 3 Mill slot .025 5 Gauzed wrapped 8 Saw cut 11 None (open hole)
 2 Louvered shutter 4 Key punched 6 Wire wrapped 9 Drilled holes
 7 Torch cut 10 Other (specify)
 SCREEN-PERFORATED INTERVALS: From 55.8 ft. to 65.8 ft., From ft. to ft.
 From ft. to ft., From ft. to ft.
 GRAVEL PACK INTERVALS: From 26 ft. to 45 ft., From ft. to ft.
 From 48 ft. to 65.8 ft., From ft. to ft.

6 GROUT MATERIAL: 1 Neat cement 2 Cement grout 3 Bentonite 4 Other
 Grout Intervals: From 5 ft. to 26 ft., From 45 ft. to 48 ft., From ft. to ft.
 What is the nearest source of possible contamination:
 1 Septic tank 4 Lateral lines 7 Pit privy 10 Livestock pens 14 Abandoned water well
 2 Sewer lines 5 Cess pool 8 Sewage lagoon 11 Fuel storage 15 Oil well/Gas well
 3 Watertight sewer lines 6 Seepage pit 9 Feedyard 12 Fertilizer storage 16 Other (specify below)
OPEN PASTURE NONE APPARENT
 Direction from well? How many feet?

FROM	TO	LITHOLOGIC LOG	FROM	TO	PLUGGING INTERVALS
0	2	TOP SOIL BLACK			
2	11	CLAY REDISH BROWN			
11	14	CLAY TAN SILTY			
14	35	SAND BROWN FINE TO COARSE			
35	63	SANDSTONE TAN WITH SMALL GRAY CLAY LAYERS			
63	66	SHALE BLUE			

7 CONTRACTOR'S OR LANDOWNER'S CERTIFICATION: This water well was (1) constructed, (2) reconstructed, or (3) plugged under my jurisdiction and was completed on (mo/day/year) 5-26-99 and this record is true to the best of my knowledge and belief. Kansas Water Well Contractor's License No. 388 This Water Well Record was completed on (mo/day/yr) 5-26-99 under the business name of PESTINGER PUMP SERVICE by (signature) Paul K. Peeling