


WATER WELL RECORD Form WWC-5 KSA 82a-1212

| | | | | |
|----------------------------------|---|----------------|-----------------|----------------|
| 1 LOCATION OF WATER WELL: | Fraction | Section Number | Township Number | Range Number |
| County: <u>Ottawa</u> | <u>NE</u> 1/4 <u>NW</u> 1/4 <u>SW</u> 1/4 | <u>36</u> | <u>T 12 S</u> | <u>R 3 E/W</u> |

Distance and direction from nearest town or city street address of well if located within city?
4 1/2 miles South & 1 mile West of Bennington, KS

2 WATER WELL OWNER: Larry & Shiela Fief
 RR#, St. Address, Box # : 36 N. 170th Rd.
 City, State, ZIP Code : Salina, KS 67401

Board of Agriculture, Division of Water Resources
 Application Number:

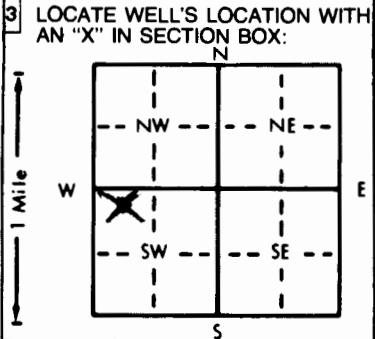

4 DEPTH OF COMPLETED WELL... 135 ft. ELEVATION:

Depth(s) Groundwater Encountered 1. ft. 2. ft. 3. ft.

WELL'S STATIC WATER LEVEL ... 70 ft. below land surface measured on mo/day/yr ... 7/29/99

Pump test data: Well water was ft. after hours pumping gpm

Est. Yield 5-8 gpm: Well water was ft. after hours pumping gpm

Bore Hole Diameter ... 9 in. to ... 135 ft., and in. to ft.

WELL WATER TO BE USED AS: 5 Public water supply 8 Air conditioning 11 Injection well
 1 Domestic 3 Feedlot 6 Oil field water supply 9 Dewatering 12 Other (Specify below)
 2 Irrigation 4 Industrial Lawn and garden only 10 Monitoring well

Was a chemical/bacteriological sample submitted to Department? Yes.....No........; If yes, mo/day/yr sample was submitted
 Water Well Disinfected? Yes No

5 TYPE OF BLANK CASING USED:

| | | | | |
|---|------------|-------------------|-------------------------|--|
| 1 Steel | 3 RMP (SR) | 5 Wrought iron | 8 Concrete tile | CASING JOINTS: Glued <input checked="" type="checkbox"/> Clamped |
| <input checked="" type="checkbox"/> PVC | 4 ABS | 6 Asbestos-Cement | 9 Other (specify below) | Welded |
| | | 7 Fiberglass | | Threaded |

Blank casing diameter ... 5 in. to ... 125 ft., Dia. in. to ft., Dia. in. to ft.

Casing height above land surface ... 12 in., weight ... 2.37 lbs./ft. Wall thickness or gauge No. ... 214

TYPE OF SCREEN OR PERFORATION MATERIAL:

| | | | | |
|---------|--------------------|-----------------|---|--------------------------|
| 1 Steel | 3 Stainless steel | 5 Fiberglass | <input checked="" type="checkbox"/> PVC | 10 Asbestos-cement |
| 2 Brass | 4 Galvanized steel | 6 Concrete tile | 8 RMP (SR) | 11 Other (specify) |
| | | | 9 ABS | 12 None used (open hole) |

SCREEN OR PERFORATION OPENINGS ARE:

| | | | | |
|--------------------|---|------------------|--------------------------|---------------------|
| 1 Continuous slot | <input checked="" type="checkbox"/> Mill slot | 5 Gauzed wrapped | 8 Saw cut | 11 None (open hole) |
| 2 Louvered shutter | 4 Key punched | 6 Wire wrapped | 9 Drilled holes | |
| | | 7 Torch cut | 10 Other (specify) | |

SCREEN-PERFORATED INTERVALS: From 125 ft. to 135 ft., From ft. to ft.

GRAVEL PACK INTERVALS: From 23 ft. to 135 ft., From ft. to ft.

6 GROUT MATERIAL: 1 Neat cement 2 Cement grout Bentonite 4 Other

Grout Intervals: From ... 3 ft. to 23 ft., From ft. to ft., From ft. to ft.

What is the nearest source of possible contamination:

| | | | | |
|--------------------------|---|-----------------|------------------------|--------------------------|
| 1 Septic tank | <input checked="" type="checkbox"/> Lateral lines | 7 Pit privy | 10 Livestock pens | 14 Abandoned water well |
| 2 Sewer lines | 5 Cess pool | 8 Sewage lagoon | 11 Fuel storage | 15 Oil well/Gas well |
| 3 Watertight sewer lines | 6 Seepage pit | 9 Feedyard | 12 Fertilizer storage | 16 Other (specify below) |
| | | | 13 Insecticide storage | |

Direction from well? West How many feet? 150

| FROM | TO | LITHOLOGIC LOG | FROM | TO | PLUGGING INTERVALS |
|------|-----|------------------|------|----|--------------------|
| 0 | 2 | Topsoil | | | |
| 2 | 11 | Tan Clay | | | |
| 11 | 17 | Sandstone | | | |
| 17 | 32 | Gray Shale | | | |
| 32 | 47 | Red Shale | | | |
| 47 | 63 | Gray Shale | | | |
| 63 | 91 | Light Gray Shale | | | |
| 91 | 123 | Dark Gray Shale | | | |
| 123 | 135 | Sandstone | | | |
| | | | | | |
| | | | | | |
| | | | | | |
| | | | | | |

7 CONTRACTOR'S OR LANDOWNER'S CERTIFICATION: This water well was (constructed, (2) reconstructed, or (3) plugged under my jurisdiction and was completed on (mo/day/year) ... 8/2/99 and this record is true to the best of my knowledge and belief. Kansas Water Well Contractor's License No. ... 138 This Water Well Record was completed on (mo/day/yr) ... 8/19/99 under the business name of PETERSON IRRIGATION, INC. by (signature) Mike Peters

INSTRUCTIONS: Use typewriter or ball point pen. PLEASE PRESS FIRMLY and PRINT clearly. Please fill in blanks, underline or circle the correct answers. Send top three copies to Kansas Department of Health and Environment, Bureau of Water, Topeka, Kansas 66620-0001. Telephone: 913-296-5545. Send one to WATER WELL OWNER and retain one for your records.

OFFICE USE ONLY
T
R
EW
SEC.
1/4
1/4
1/4