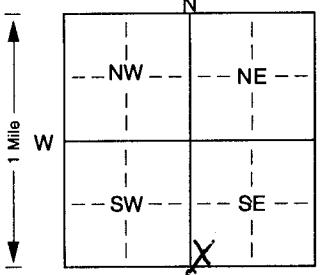


1 LOCATION OF WATER WELL: Fraction SW 1/4 SW 1/4 SE 1/4 Section Number 30 Township Number T 12 S Range Number R 3 **EW**  
 County: Ottawa  
 Distance and direction from nearest town or city street address of well if located within city?  
3.75 miles E of Culver, Ks on Aspon Rd., North side, of Pond 150' NW

2 WATER WELL OWNER: Glen Miller  
 RR#, St. Address, Box #: 901 E. Stimuel Rd  
 City, State, ZIP Code: Salina, Ks, 67401  
 Board of Agriculture, Division of Water Resources  
 Application Number:

3 LOCATE WELL'S LOCATION WITH AN "X" IN SECTION BOX:  
  
 4 DEPTH OF COMPLETED WELL: 117.5 ft. ELEVATION:  
 Depth(s) Groundwater Encountered 1. . . . . ft. 2. . . . . ft. 3. . . . . ft.  
 WELL'S STATIC WATER LEVEL: 55 ft. below land surface measured on mo/day/yr 5/22/01  
 Pump test data: Well water was . . . . . ft. after . . . . . hours pumping . . . . . gpm  
 Est. Yield 1.5 gpm: Well water was . . . . . ft. after . . . . . hours pumping . . . . . gpm  
 Bore Hole Diameter: 8 3/4 in. to 11.8 ft., and . . . . . in. to . . . . . ft.  
 WELL WATER TO BE USED AS: 5 Public water supply 8 Air conditioning 11 Injection well  
 1 Domestic 3 Feedlot 6 Oil field water supply 9 Dewatering 12 Other (Specify below)  
 2 Irrigation 4 Industrial 7 Domestic (lawn & garden) 10 Monitoring well . . . . .  
 Was a chemical/bacteriological sample submitted to Department? Yes. . . . . No.  ; If yes, mo/day/yr sample was submitted  
 Water Well Disinfected? Yes  No

5 TYPE OF BLANK CASING USED:  
 1 Steel 3 RMP (SR) 5 Wrought iron 8 Concrete tile CASING JOINTS: Glued.  Clamped. . . . .  
2 PVC 4 ABS 7 Fiberglass 9 Other (specify below) Welded . . . . .  
 Threaded. . . . .  
 Blank casing diameter 5 in. to 57.5 ft., Dia. 5 in. to 97.5 ft., Dia. . . . . in. to . . . . . ft.  
 Casing height above land surface: 24 in., weight sch 40 lbs./ft. Wall thickness or gauge No. . . . .  
 TYPE OF SCREEN OR PERFORATION MATERIAL: 7 PVC 10 Asbestos-cement  
 1 Steel 3 Stainless steel 5 Fiberglass 8 RMP (SR) 11 Other (specify) . . . . .  
 2 Brass 4 Galvanized steel 6 Concrete tile 9 ABS 12 None used (open hole)  
 SCREEN OR PERFORATION OPENINGS ARE:  
 1 Continuous slot 3 Mill slot 5 Gauzed wrapped 8 Saw cut 11 None (open hole)  
 2 Louvered shutter 4 Key punched 6 Wire wrapped 9 Drilled holes  
 7 Torch cut 10 Other (specify) . . . . . ft.  
 SCREEN-PERFORATED INTERVALS: From: 117.5 ft. to 97.5 ft., From: 77.5 ft. to 57.5 ft.  
 From: . . . . . ft. to . . . . . ft., From: . . . . . ft. to . . . . . ft.  
 GRAVEL PACK INTERVALS: From: 11.8 ft. to 23 ft., From: . . . . . ft. to . . . . . ft.  
 From: . . . . . ft. to . . . . . ft., From: . . . . . ft. to . . . . . ft.

6 GROUT MATERIAL: 1 Neat cement 2 Cement grout 3 Bentonite 4 Other . . . . .  
 Grout Intervals: From: 23 ft. to 3 ft., From: . . . . . ft. to . . . . . ft., From: . . . . . ft. to . . . . . ft.  
 What is the nearest source of possible contamination:  
 1 Septic tank 4 Lateral lines 7 Pit privy 10 Livestock pens 14 Abandoned water well  
 2 Sewer lines 5 Cess pool 8 Sewage lagoon 11 Fuel storage 15 Oil well/Gas well  
 3 Watertight sewer lines 6 Seepage pit 9 Feedyard 12 Fertilizer storage 16 Other (specify below)  
Pond  
 Direction from well? SE How many feet? 150

FROM	TO	LITHOLOGIC LOG	FROM	TO	PLUGGING INTERVALS
0	5	Clay - sandy, orange brown	95	110	Shale - gray with Sandstone lenses
5	9	Sand - fine, clayey, orange brown	110	118	Sandstone
9	25	Shale - orange, tan, gray, with Sandstone lenses			
25	45	Shale - dk. gray			
45	46	Sandstone			
46	51	Shale - gray			
51	52	Sandstone			
52	76	Sandstone and shale, gray			
76	78	Shale			
78	81	Sandstone			
81	84	Shale + Sandstone, coal, pyrite			
84	95	Sandstone - pyrite + shale			

7 CONTRACTOR'S OR LANDOWNER'S CERTIFICATION: This water well was (1) constructed, (2) reconstructed, or (3) plugged under my jurisdiction and was completed on (mo/day/year) 5/21/01 and this record is true to the best of my knowledge and belief. Kansas Water Well Contractor's Licence No. 527 This Water Well Record was completed on (mo/day/yr) 5/26/01 under the business name of GeoCore, Inc by (signature) Don Bell