

CORRECTION TO WATER WELL RECORD (WWC-5)

The following correction(s) was made to the attached WWC-5 log, in order to file the item or to rectify lacking or incorrect information.

Fraction ( 1/4 1/4 1/4) Section-Township-Range changed:

listed as NE SE SW, 6-12S-23W

changed to NE NE SE, 1-12S-3W

Other changes: Initial statements: \_\_\_\_\_

Changed to: \_\_\_\_\_

Comments: \_\_\_\_\_

verification method: well address, city map on internet, and


Bennington 1:24,000 topo map. initials: DRD date: 4/11/2002

submitted by: Kansas Geological Survey, Data Resources Library, 1930 Constant Ave., Lawrence, KS 66047-3726  
to: Kansas Dept of Health & Environment Bureau of Water Industrial Programs, Bldg 283, Forbes Field, KS 66620

1 LOCATION OF WATER WELL:	Fraction	Section Number	Township Number	Range Number
County: <u>0 TAWA</u>	<u>NE 1/4 SE 1/4 SW 1/4</u>	<u>6</u>	<u>T 12 S</u>	<u>R 2-3W EW</u>

Distance and direction from nearest town or city street address of well if located within city?  
509 N. NELSON

2 WATER WELL OWNER: JOYCE REGNIER  
 RR#, St. Address, Box # : 509 N. NELSON Board of Agriculture, Division of Water Resources  
 City, State, ZIP Code : BENNINGTON, KS. 67401 Application Number:

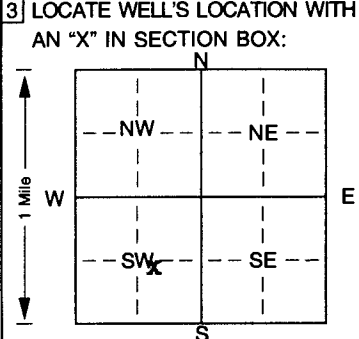

4 DEPTH OF COMPLETED WELL: 42 ft. ELEVATION: .....

Depth(s) Groundwater Encountered 1. 28 ft. 2. .... ft. 3. .... ft.

WELL'S STATIC WATER LEVEL 28 ft. below land surface measured on mo/day/yr 7-6-01

Pump test data: Well water was 32 ft. after 1 hours pumping 12 gpm

Est. Yield 20 gpm: Well water was ..... ft. after ..... hours pumping ..... gpm

Bore Hole Diameter. 9 in. to 42 ft., and ..... in. to ..... ft.

WELL WATER TO BE USED AS: 5 Public water supply 8 Air conditioning 11 Injection well  
 1 Domestic 3 Feedlot 6 Oil field water supply 9 Dewatering 12 Other (Specify below)  
 2 Irrigation 4 Industrial 7 Domestic (lawn & garden) 10 Monitoring well .....

Was a chemical/bacteriological sample submitted to Department? Yes. .... No. X ; If yes, mo/day/yr sample was submitted

Water Well Disinfected? Yes X No

5 TYPE OF BLANK CASING USED:

1 Steel	3 RMP (SR)	6 Asbestos-Cement	9 Other (specify below)	Welded .....
<u>2 PVC</u>	4 ABS	7 Fiberglass	.....	Threaded .....

CASING JOINTS: Glued. X Clamped. ....

Blank casing diameter 5 in. to 32 ft., Dia ..... in. to ..... ft., Dia ..... in. to ..... ft.

Casing height above land surface. 20 in., weight 160 lbs./ft. Wall thickness or gauge No. SDR 26

TYPE OF SCREEN OR PERFORATION MATERIAL:

1 Steel	3 Stainless steel	5 Fiberglass	8 RMP (SR)	10 Asbestos-cement
2 Brass	4 Galvanized steel	6 Concrete tile	9 ABS	11 Other (specify) .....
				12 None used (open hole)

SCREEN OR PERFORATION OPENINGS ARE:

1 Continuous slot	<u>3 Mill slot .025</u>	5 Gauzed wrapped	8 Saw cut	11 None (open hole)
2 Louvered shutter	4 Key punched	6 Wire wrapped	9 Drilled holes	.....
		7 Torch cut	10 Other (specify) .....	ft.

SCREEN-PERFORATED INTERVALS: From 32 ft. to 42 ft., From ..... ft. to ..... ft.

GRAVEL PACK INTERVALS: From 22 ft. to 42 ft., From ..... ft. to ..... ft.

6 GROUT MATERIAL: 1 Neat cement 2 Cement grout 3 Bentonite 4 Other .....

Grout Intervals: From 0 ft. to 22 ft., From ..... ft. to ..... ft., From ..... ft. to ..... ft.

What is the nearest source of possible contamination:

1 Septic tank	4 Lateral lines	7 Pit privy	10 Livestock pens	14 Abandoned water well
2 Sewer lines	5 Cess pool	8 Sewage lagoon	11 Fuel storage	15 Oil well/Gas well
<u>3 Watertight sewer lines</u>	6 Seepage pit	9 Feedyard	12 Fertilizer storage	16 Other (specify below)
			13 Insecticide storage	.....

Direction from well? WEST How many feet? 30

FROM	TO	LITHOLOGIC LOG	FROM	TO	PLUGGING INTERVALS
0	2	FILL DIRT			
2	21	CLAY TAN SILTY			
21	28	SAND BROWN VERY SILTY			
28	32	CLAY BROWN			
32	42	SAND TAN FINE			
42		SHALE			

7 CONTRACTOR'S OR LANDOWNER'S CERTIFICATION: This water well was (1) constructed, (2) reconstructed, or (3) plugged under my jurisdiction and was completed on (mo/day/year) 7-6-01 and this record is true to the best of my knowledge and belief. Kansas Water Well Contractor's Licence No. 388 This Water Well Record was completed on (mo/day/yr) 7-9-01 under the business name of PESTINGER PUMP SERVICE by (signature) Paul Pestinger

INSTRUCTIONS: Use typewriter or ball point pen. PLEASE PRESS FIRMLY and PRINT clearly. Please fill in blanks, underline or circle the correct answers. Send top three copies to Kansas Department of Health and Environment, Bureau of Water, Topeka, Kansas 66620-0001. Telephone 785-296-5524. Send one to WATER WELL OWNER and retain one for your records. Fee of \$5.00 for each constructed well.