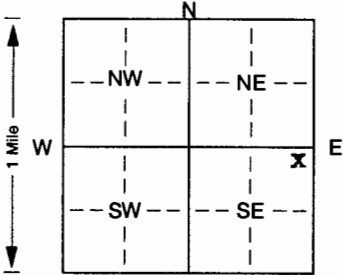


WATER WELL RECORD Form WWC-5 KSA 82a-1212 ID No.

1 LOCATION OF WATER WELL: Fraction NE 1/4 NE 1/4 SE 1/4 Section Number 27 Township Number T 12 S Range Number R 3W EW  
 County: OTTAWA

Distance and direction from nearest town or city street address of well if located within city?  
1/2 MILE NORTH OF INTERSECTION ASPEN RD. & 160th RD. WEST SIDE

2 WATER WELL OWNER: ELVIN GERARD  
 RR#, St. Address, Box #: 829 MILLWOOD DR. Board of Agriculture, Division of Water Resources  
 City, State, ZIP Code: SALINA, KS. 67401 Application Number:

3 LOCATE WELL'S LOCATION WITH AN "X" IN SECTION BOX:  
  
 4 DEPTH OF COMPLETED WELL: 100 ft. ELEVATION:  
 Depth(s) Groundwater Encountered 1... 50 ft. 2... ft. 3... ft.  
 WELL'S STATIC WATER LEVEL: 40 ft. below land surface measured on mo/day/yr 9-12-01  
 Pump test data: Well water was 96 ft. after 1 hours pumping 7 gpm  
 Est. Yield 7 to 8 gpm: Well water was ... ft. after ... hours pumping ... gpm  
 Bore Hole Diameter: 9 in. to 10 3/4 in. to ... in. to ... ft.  
 WELL WATER TO BE USED AS: 5 Public water supply 8 Air conditioning 11 Injection well  
1 Domestic 3 Feedlot 6 Oil field water supply 9 Dewatering 12 Other (Specify below)  
 2 Irrigation 4 Industrial 7 Domestic (lawn & garden) 10 Monitoring well ...  
 Was a chemical/bacteriological sample submitted to Department? Yes. ... No. X ... ; If yes, mo/day/yr sample was submitted Water Well Disinfected? Yes X No

5 TYPE OF BLANK CASING USED:  
 1 Steel 3 RMP (SR) 5 Wrought iron 8 Concrete tile CASING JOINTS: Glued. X Clamped. ...  
 2 PVC 4 ABS 7 Fiberglass 9 Other (specify below) Welded ...  
 6 Asbestos-Cement Threaded ...  
 Blank casing diameter: 5 in. to 80 ft., Dia. ... in. to ... ft., Dia. ... in. to ... ft.  
 Casing height above land surface: 30 in., weight 160 lbs./ft. Wall thickness or gauge No. SDR 26  
 TYPE OF SCREEN OR PERFORATION MATERIAL:  
 1 Steel 3 Stainless steel 5 Fiberglass 7 PVC 10 Asbestos-cement  
 2 Brass 4 Galvanized steel 6 Concrete tile 8 RMP (SR) 11 Other (specify) ...  
 9 ABS 12 None used (open hole)  
 SCREEN OR PERFORATION OPENINGS ARE:  
 1 Continuous slot 3 Mill slot .025 5 Gauzed wrapped 8 Saw cut 11 None (open hole)  
 2 Louvered shutter 4 Key punched 7 Torch cut 9 Drilled holes  
 6 Wire wrapped 10 Other (specify) ... ft.  
 SCREEN-PERFORATED INTERVALS: From 80 ft. to 100 ft., From ... ft. to ... ft.  
 From ... ft. to ... ft., From ... ft. to ... ft.  
 GRAVEL PACK INTERVALS: From 22 ft. to 64 ft., From 66 ft. to 100 ft.  
 From ... ft. to ... ft., From ... ft. to ... ft.

6 GROUT MATERIAL: 1 Neat cement 2 Cement grout 3 Bentonite 4 Other ...  
 Grout Intervals: From 0 ft. to 22 ft., From 64 ft. to 66 ft., From ... ft. to ... ft.  
 What is the nearest source of possible contamination:  
 1 Septic tank 4 Lateral lines 7 Pit privy 10 Livestock pens 14 Abandoned water well  
 2 Sewer lines 5 Cess pool 8 Sewage lagoon 11 Fuel storage 15 Oil well/Gas well  
 3 Watertight sewer lines 6 Seepage pit 9 Feedyard 12 Fertilizer storage 16 Other (specify below)  
 13 Insecticide storage OPEN PASTURE NONE APPARENT  
 Direction from well? How many feet?

FROM	TO	LITHOLOGIC LOG	FROM	TO	PLUGGING INTERVALS
0	2	TOP SOIL			
2	11	CLAY BROWN			
11	18	CLAY GRAY			
18	26	CLAY DARK GRAY			
26	41	CLAY LIGHT GRAY			
41	42	CEMENTED SANDSTONE HARD GRAY			
42	50	CLAY GRAY			
50	58	SANDSTONE BROWN			
58	78	CLAY GRAY			
78	82	SANDSTONE GRAY			
82	90	CLAY GRAY			
90	100	SANDSTONE GRAY HARD			
100	103	SHALE GRAY			

7 CONTRACTOR'S OR LANDOWNER'S CERTIFICATION: This water well was (1) constructed, (2) reconstructed, or (3) plugged under my jurisdiction and was completed on (mo/day/year) 9-12-01 and this record is true to the best of my knowledge and belief. Kansas Water Well Contractor's Licence No. 388. This Water Well Record was completed on (mo/day/yr) 9-14-01 under the business name of PESTINGER PUMP SERVICE by (signature) [Signature]

INSTRUCTIONS: Use typewriter or ball point pen. PLEASE PRESS FIRMLY and PRINT clearly. Please fill in blanks, underline or circle the correct answers. Send two copies to Kansas Department of Health and Environment, Bureau of Water, Topeka, Kansas 66620-0001. Telephone 785-296-5524. Send one to WATER WELL OWNER and retain one for your records. Fee of \$5.00 for each constructed well.