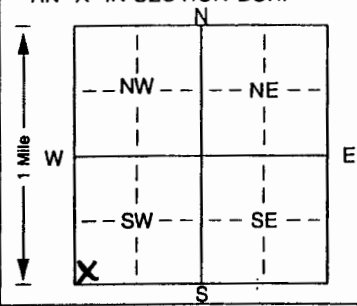


1 LOCATION OF WATER WELL: Fraction SW 1/4 SW 1/4 SW 1/4 Section Number 18 Township Number T 12 S Range Number R 3 N E
 County: Ottawa

Distance and direction from nearest town or city street address of well if located within city?

NE of intersection of Coronado and 120th Roads, Ottawa County

2 WATER WELL OWNER: Jason Chard
 RR#, St. Address, Box #: 508 N. Putnam Board of Agriculture, Division of Water Resc
 City, State, ZIP Code: Bennington, Kansas 67422 Application Number:

3 LOCATE WELL'S LOCATION WITH AN "X" IN SECTION BOX:  4 DEPTH OF COMPLETED WELL: 55 ft. ELEVATION:
 Depth(s) Groundwater Encountered 1. 24 ft. 2. ft. 3. ft.
 WELL'S STATIC WATER LEVEL: 24.8 ft. below land surface measured on mo/day/yr 7/10/02
 Pump test data: Well water was ft. after hours pumping
 Est. Yield 15 gpm: Well water was ft. after hours pumping
 Bore Hole Diameter: 8.5 in. to 60 in. to
 WELL WATER TO BE USED AS: 5 Public water supply 8 Air conditioning 11 Injection well
 Domestic 3 Feedlot 6 Oil field water supply 9 Dewatering 12 Other (Specify below)
 2 Irrigation 4 Industrial 7 Domestic (lawn & garden) 10 Monitoring well
 Was a chemical/bacteriological sample submitted to Department? Yes. No. ; If yes, mo/day/yrs sample was mitted
 Water Well Disinfected? Yes No

5 TYPE OF BLANK CASING USED: 1 Steel 2 RMP (SR) 3 Stainless steel 4 Galvanized steel 5 Wrought iron 6 Asbestos-Cement 7 Fiberglass 8 Concrete tile 9 Other (specify below) CASING JOINTS: Glued Clamped...
 PVC 4 ABS 7 Fiberglass
 Blank casing diameter 5 in. to 25 in. Dia lbs./ft. Wall thickness or gauge No. Sch 40
 Casing height above land surface 18 in, weight
 TYPE OF SCREEN OR PERFORATION MATERIAL: 1 Steel 2 Brass 3 Stainless steel 4 Galvanized steel 5 Fiberglass 6 Concrete tile 7 PVC 8 RMP (SR) 9 ABS 10 Asbestos-cement 11 Other (specify) 12 None used (open hole)
 SCREEN OR PERFORATION OPENINGS ARE: 1 Continuous slot 2 Louvered shutter 3 Mill slot 4 Key punched 5 Gauzed wrapped 6 Wire wrapped 7 Torch cut 8 Saw cut 9 Drilled holes 10 Other (specify) 11 None (open hole)
 SCREEN-PERFORATED INTERVALS: From 55 ft. to 25 ft. From ft. to ft.
 GRAVEL PACK INTERVALS: From 58 ft. to 23 ft. From ft. to ft.

6 GROUT MATERIAL: 1 Neat cement 2 Cement grout 3 Bentonite 4 Other
 Grout Intervals: From 23 ft. to 0 ft. From ft. to ft. From ft. to ft.
 What is the nearest source of possible contamination:
 1 Septic tank 2 Sewer lines 3 Watertight sewer lines 4 Lateral lines 5 Cess pool 6 Seepage pit 7 Pit privy 8 Sewage lagoon 9 Feedyard 10 Livestock pens 11 Fuel storage 12 Fertilizer storage 13 Insecticide storage 14 Abandoned water well 15 Oil well/Gas well 16 Other (specify below) None
 Direction from well? How many feet?

FROM	TO	LITHOLOGIC LOG	FROM	TO	PLUGGING INTERVALS
0	18	Clay			
18	30	Shale - Gray, Red, Yellow, Sandy			
30	40	Shale - with sandstone, Gray, Yellow			
40	43	Sandstone - shaly, Gray, Yellow			
43	45	Shale - Gray, Yellow			
45	50	Sandstone - shaly			
50	58	Sandstone			
58	60	Shale - Gray			

7 CONTRACTOR'S OR LANDOWNER'S CERTIFICATION: This water well was constructed, (2) reconstructed, or (3) plugged under my jurisdiction and was completed on (mo/day/year) 7/12/02 and this record is true to the best of my knowledge and belief. Kans Water Well Contractor's Licence No. 527 This Water Well Record was completed on (mo/day/yr) 7/26/02 under the business name of GeoCore Inc. by (signature) Dale A Bell