


1	LOCATION OF WATER WELL:	Fraction	Section Number	Township Number	Range Number
	County: Ottawa	Near ^{1/4} Center ^{1/4} NW	35	12	3 W

Distance and direction from nearest town or city street address of well if located within city?
4 miles South, 1-1/2 West of Bennington, Ks

2 WATER WELL OWNER: **John Adams**
1311 Faith Dr.
 RR #, St. Address, Box #: **Salina, Ks. 67401**
 City, State, ZIP Code :
 Board of Agriculture, Division of Water Resources
 Application Number:

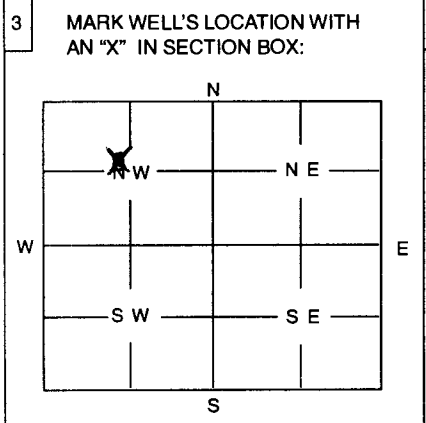

4 DEPTH OF WELL **5 @ 200** ft
 WELL'S STATIC WATER LEVEL ft.
 WELL WAS USED AS:
 1 Domestic 5 Public Water Supply 9 Dewatering
 2 Irrigation 6 Oil Field Water Supply 10 Monitoring Well
 3 Feedlot 7 Domestic (Lawn & Garden) 11 Injection Well
 4 Industrial 8 Air Conditioning Other **Heatpump**.....

Was a chemical / bacteriological sample submitted to Department? Yes No
 If yes, mo/day/yr sample was submitted

Water Well Disinfected: Yes No

5 TYPE OF BLANK CASING USED:
 1 Steel 3 RMP (SR) 5 Wrought 7 Fiberglass Other (Specify below)
 2 PVC 4 ABS 6 Asbestos-Cement 8 Concrete Tile **Polyethylene**.....

Blank casing diameter **3/4** in. Was casing pulled? Yes No If yes, how much

Casing height above or below land surface in.

6 GROUT PLUG MATERIAL: 1 Neat cement 2 Cement grout **Bentonite** 4 Other

Grout Plug Intervals: From **3** ft. to **200** ft., From **3** ft. to **200** ft., From **3** to **200** ft.
From 3 ft to 200 ft, From 3 ft to 200 ft

What is the nearest source of possible contamination:
 1 Septic tank 6 Seepage pit 11 Fuel storage 16 Other (specify below)
 Sewer lines 7 Pit privy 12 Fertilizer storage
 3 ~~Water~~ **tight** sewer lines 8 Sewage lagoon 13 Insecticide storage
 4 Lateral lines 9 Feedyard 14 Abandoned water well
 5 Cess Pool 10 Livestock pens 15 Oil well/Gas well

Direction from well? **South** How many feet? **100**

FROM	TO	PLUGGING MATERIALS
0	35	Sandstone, w/small layers of shale and iron pyrite
35	95	Sandstone, light gray
95	100	Shale, xxx gray
100	110	Shale, red
110	118	Sandstone, light gray
118	125	Shale, red

125 to 135 Sandstone, light gray
 135 to 150 Shale, gray
 150 to 180 Sandstone, light gray
 180 to 183 Iron pyrite
 183 to 200 Shale, gray

7 CONTRACTOR'S OR LANDOWNER'S CERTIFICATION: This water well was plugged under my jurisdiction and was completed on (mo/day/year) **5/22/04** and this record is true to the best of my knowledge and belief. Kansas Water Well Contractor's License No. **138** This Water Well Record was completed on (mo/day/year) **5-27-04** under the business name of **Peterson Irrigation, Inc.** by (signature) *[Signature]* **5-27-04**

INSTRUCTIONS: Use typewriter or ball point pen. Please press firmly and print clearly. Please fill in blanks, underline or circle the correct answers. Send top three copies to Kansas Department of Health and Environment, Bureau of Water, Topeka, Kansas 66620-0001. Telephone: 785/296-3565. Send one to Water Well Owner and retain one for your records.