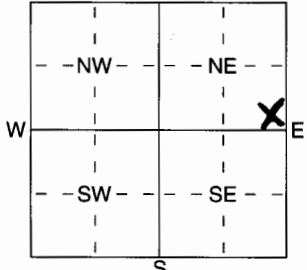


1 LOCATION OF WATER WELL: Fraction **SE 1/4 SE 1/4 NE 1/4** Section Number **15** Township Number **T 12 S** Range Number **R 3 EW**  
 County: **Ottawa**

Distance and direction from nearest town or city street address of well if located within city?  
**2 miles West & 1-1/2 miles South of Bennington, Ks.**

2 WATER WELL OWNER: **Roy & Vicky Cooper**  
 RR#, St. Address, Box # : **359 N. 160th Rd. PO Box 35** Board of Agriculture, Division of Water Resources  
 City, State, ZIP Code : **Bennington, Ks. 67422** Application Number:

3 LOCATE WELL'S LOCATION WITH AN "X" IN SECTION BOX:  4 DEPTH OF COMPLETED WELL **105** ft. ELEVATION: ..... ft.  
 Depth(s) Groundwater Encountered **68** ft. 1 ..... ft. 2 ..... ft. 3 **9/27/05** ft.  
 WELL'S STATIC WATER LEVEL **68** ft. below land surface measured on mo/day/yr  
 Pump test data: Well water was ..... ft. after ..... hours pumping ..... gpm  
 Est. Yield **20** gpm: Well water was ..... ft. after ..... hours pumping ..... gpm  
 WELL WATER TO BE USED AS: 5 Public water supply 8 Air conditioning 11 Injection well  
 1 Domestic 3 Feedlot 6 Oil field water supply 9 Dewatering 12 Other (Specify below)  
 2 Irrigation 4 Industrial **X Domestic (lawn & garden)** 10 Monitoring well .....  
 Was a chemical/bacteriological sample submitted to Department? Yes ..... No **X** .....; If yes, mo/day/yr sample was submitted  
 Water Well Disinfected? Yes **X** No

5 TYPE OF BLANK CASING USED: 5 Wrought iron 8 Concrete tile CASING JOINTS: Glued **X** Clamped .....  
 1 Steel 3 RMP (SR) 6 Asbestos-Cement 9 Other (specify below) Welded .....  
**X PVC** 4 ABS 7 Fiberglass Threaded .....  
 Blank casing diameter **5** in. to **8.5** ft., Dia ..... in. to ..... ft.  
 Casing height above land surface **12** in., weight **2.37** lbs./ft. Wall thickness or gauge No. **.214**  
 TYPE OF SCREEN OR PERFORATION MATERIAL: **X PVC** 10 Asbestos-Cement  
 1 Steel 3 Stainless Steel 5 Fiberglass 8 RMP (SR) 11 Other (Specify) .....  
 2 Brass 4 Galvanized Steel 6 Concrete tile 9 ABS 12 None used (open hole)  
 SCREEN OR PERFORATION OPENINGS ARE: 5 Gauzed wrapped 8 Saw cut 11 None (open hole)  
 1 Continuous slot **X Mill slot** 6 Wire wrapped 9 Drilled holes  
 2 Louvered shutter 4 **Key punched** 7 Torch cut 10 Other (specify) ..... ft.  
 SCREEN-PERFORATED INTERVALS: From **8.5** ft. to **10.5** ft., From ..... ft. to ..... ft.  
 From ..... ft. to ..... ft., From ..... ft. to ..... ft.  
 GRAVEL PACK INTERVALS: From **20** ft. to **10.5** ft., From ..... ft. to ..... ft.  
 From ..... ft. to ..... ft., From ..... ft. to ..... ft.

6 GROUT MATERIAL: 1 Neat cement 2 Cement grout **X Bentonite** 4 Other .....  
 Grout Intervals: From **0** ft. to **20** ft., From ..... ft. to ..... ft.  
 What is the nearest source of possible contamination: 10 Livestock pens 14 Abandoned water well  
 1 Septic tank 4 Lateral lines 7 Pit privy 11 Fuel storage 15 Oil well/Gas well  
 2 Sewer lines 5 Cess pool **X Sewage lagoon** 12 Fertilizer storage 16 Other (specify below)  
 3 Watertight sewer lines 6 Seepage pit 9 Feedyard 13 Insecticide storage .....  
 Direction from well? **South west** How many feet? **150 ft**

FROM	TO	LITHOLOGIC LOG	FROM	TO	PLUGGING INTERVALS
0	2	Topsoil			
2	12	Clay, tan			
12	65	Shale, gray			
65	104	Sandstone			
104	107	Shale, gray			
107	--	Hard rock			

7 CONTRACTOR'S OR LANDOWNER'S CERTIFICATION: This water well was **X** constructed, (2) reconstructed, or (3) plugged under my jurisdiction and was completed on (mo/day/year) **9/28/05** and this record is true to the best of my knowledge and belief. Kansas Water Well Contractor's Licence No **138** This Water Well Record was completed on (mo/day/yr) **9/30/05** under the business name of **Peterson Irrigation, Inc.** by (signature) *Mike Peterson*