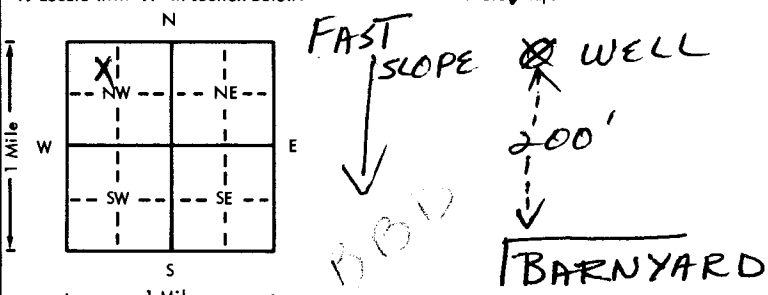


USE TYPEWRITER OR BALL POINT PEN-PRESS FIRMLY, PRINT CLEARLY.

WATER WELL RECORD
KSA 82a-1201-1215

Kansas Department of Health and Environment-Division of Environment
(Water well Contractors)
Topeka, Kansas 66620

1. Location of well: County OTTOWA Fraction CE 1/2 NW 1/4 NW 1/4 Section number 4 Township number T 12 S R 3 Range number EW	
2. Distance and direction from nearest town or city: 3 West - 1 N Street address of well location if in city: 34 West 0.6 Bennington	
3. Owner of well: FRANK EWART R.R. or street: 220 N ROTHSAU City, state, zip code: MINNEAPOLIS, KANS 67467	
4. Locate with "X" in section below: Sketch map: 	
6. Bore hole dia. 8 in. Completion date 4/18/75 Well depth 120 ft.	
7. <input type="checkbox"/> Cable tool <input checked="" type="checkbox"/> Rotary <input type="checkbox"/> Driven <input type="checkbox"/> Dug <input type="checkbox"/> Hollow rod <input type="checkbox"/> Jetted <input type="checkbox"/> Bored <input type="checkbox"/> Reverse rotary	
8. Use: <input checked="" type="checkbox"/> Domestic <input type="checkbox"/> Public supply <input type="checkbox"/> Industry <input type="checkbox"/> Irrigation <input type="checkbox"/> Air conditioning <input checked="" type="checkbox"/> Stock <input type="checkbox"/> Lawn <input type="checkbox"/> Oil field water <input type="checkbox"/> Other	
9. Casing: Material PVC Height: Above or below Threaded <input type="checkbox"/> Welded <input checked="" type="checkbox"/> Surface 15 in. RMP <input type="checkbox"/> PVC <input checked="" type="checkbox"/> Weight 3 lbs./ft. Dia. 5 in. to 20 ft. depth Wall Thickness: inches or Dia. <input type="checkbox"/> in. to <input type="checkbox"/> ft. depth gage No. 160 #	
5. Type and color of material	
	From To
TOPSOIL	0 2
Brown clay	2 16
Sandrock	16 60
Sandrock w/ clay layers	60 91
Sandrock	91 120
Stop	120
10. Screen: Manufacturer's name CERTAINTEED Type PVC Dia. 5 Slot/gauze 4/16 Length 20 Set between 100 ft. and 120 ft. ft. and <input type="checkbox"/> ft. Gravel pack? YES Size range of material 5X4	
11. Static water level: <input type="checkbox"/> mo./day/yr. 40 ft. below land surface Date 4/18/75	
12. Pumping level below land surfaces: <input type="checkbox"/> ft. after <input type="checkbox"/> hrs. pumping <input type="checkbox"/> g.p.m. <input type="checkbox"/> ft. after NA hrs. pumping <input type="checkbox"/> g.p.m. Estimated maximum yield 25 g.p.m.	
13. Water sample submitted: <input type="checkbox"/> mo./day/yr. Yes <input checked="" type="checkbox"/> No <input type="checkbox"/> Date <input type="checkbox"/>	
14. Well head completion: <input type="checkbox"/> Pitless adapter <input checked="" type="checkbox"/> Inches above grade	
15. Well grouted? <input checked="" type="checkbox"/> With: <input checked="" type="checkbox"/> Neat cement <input type="checkbox"/> Bentonite <input type="checkbox"/> Concrete Depth: From 0 ft. to 10 ft.	
16. Nearest source of possible contamination: ft. 200 Direction SOUTH Type <input type="checkbox"/> Well disinfected upon completion? <input checked="" type="checkbox"/> Yes <input type="checkbox"/> No	
17. Pump: <input checked="" type="checkbox"/> Not installed Manufacturer's name <input type="checkbox"/> Model number <input type="checkbox"/> HP <input type="checkbox"/> Volts <input type="checkbox"/> Length of drop pipe <input type="checkbox"/> ft. capacity <input type="checkbox"/> g.p.m. Type: <input type="checkbox"/> Submersible <input type="checkbox"/> Turbine <input type="checkbox"/> Jet <input type="checkbox"/> Reciprocating <input type="checkbox"/> Centrifugal <input type="checkbox"/> Other	
(Use a second sheet if needed)	
18. Elevation: ~1270 Topography: <input checked="" type="checkbox"/> Hill <input type="checkbox"/> Slope <input type="checkbox"/> Upland <input type="checkbox"/> Valley	19. Remarks:
20. Water well contractor's certification: This well was drilled under my jurisdiction and this report is true to the best of my knowledge and belief. GEO COX + SONS INC 258 Business name License No. Address SLIFTON, KANSAS Signed Daryl Cox Date 4/18/75 Authorized representative	

T 12 S R 3 E W 1/4 CE 1/2 NW NW