


1 LOCATION OF WATER WELL: Fraction NW 1/4 SW 1/4 NW 1/4 Section Number 15 Township Number T 12 S Range Number R 3 **W**
 County: Ottawa

Distance and direction from nearest town or city street address of well if located within city?
 3 miles West of Bennington, KS 2 miles South

2 WATER WELL OWNER: Perry Becker
 RR#, St. Address, Box #: 348 N. Penn Board of Agriculture, Division of Water Resources
 City, State, ZIP Code: Salina, KS 67401 Application Number:

3 LOCATE WELL'S LOCATION WITH AN "X" IN SECTION BOX: 4 DEPTH OF COMPLETED WELL: 158 ft. ELEVATION: 2120
 Depth(s) Groundwater Encountered 1. 67 ft. 2. ft. 3. ft.

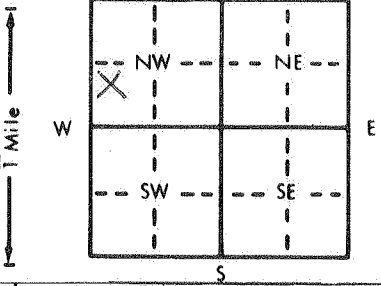

WELL'S STATIC WATER LEVEL 67 ft. below land surface measured on mo/day/yr 8/19/87
 Pump test data: Well water was ft. after hours pumping gpm
 Est. Yield 5-10 gpm: Well water was 120 ft. after 2 hours pumping 5 gpm
 Bore Hole Diameter 8 in. to 158 ft., and in. to ft.
 WELL WATER TO BE USED AS: 5 Public water supply 8 Air conditioning 11 Injection well
 1 Domestic 3 Feedlot 6 Oil field water supply 9 Dewatering 12 Other (Specify below)
 2 Irrigation 4 Industrial 7 Lawn and garden only 10 Observation well
 Was a chemical/bacteriological sample submitted to Department? Yes No ; If yes, mo/day/yr sample was submitted
 Water Well Disinfected? Yes No

5 TYPE OF BLANK CASING USED: 5 Wrought iron 8 Concrete tile CASING JOINTS: Glued Clamped
 1 Steel 3 RMP (SR) 6 Asbestos-Cement 9 Other (specify below) Welded
 2 PVC 4 ABS 7 Fiberglass Threaded
 Blank casing diameter 5 in. to 138 ft., Dia in. to ft., Dia in. to ft.
 Casing height above land surface 12 in., weight 2.91 lbs./ft. Wall thickness or gauge No. 265

TYPE OF SCREEN OR PERFORATION MATERIAL: 7 PVC 10 Asbestos-cement
 1 Steel 3 Stainless steel 5 Fiberglass 8 RMP (SR) 11 Other (specify)
 2 Brass 4 Galvanized steel 6 Concrete tile 9 ABS 12 None used (open hole)

SCREEN OR PERFORATION OPENINGS ARE: 5 Gauzed wrapped 8 Saw cut 11 None (open hole)
 1 Continuous slot 3 Mill slot 6 Wire wrapped 9 Drilled holes
 2 Louvered shutter 4 Key punched 7 Torch cut 10 Other (specify)

SCREEN-PERFORATED INTERVALS: From 138 ft. to 158 ft., From ft. to ft.
 From ft. to ft., From ft. to ft.
 GRAVEL PACK INTERVALS: From 20 ft. to 158 ft., From ft. to ft.
 From ft. to ft., From ft. to ft.

6 GROUT MATERIAL: 1 Neat cement 2 Cement grout 3 Bentonite 4 Other
 Grout Intervals: From 0 ft. to 20 ft., From ft. to ft., From ft. to ft.

What is the nearest source of possible contamination:
 1 Septic tank 4 Lateral lines 7 Pit privy 10 Livestock pens 14 Abandoned water well
 2 Sewer lines 5 Cess pool 8 Sewage lagoon 11 Fuel storage 15 Oil well/Gas well
 3 Watertight sewer lines 6 Seepage pit 9 Feedyard 12 Fertilizer storage 16 Other (specify below)
 13 Insecticide storage
 Direction from well? None within 1/2 mile How many feet?

FROM	TO	LITHOLOGIC LOG	FROM	TO	LITHOLOGIC LOG
0	4	Top Soil			
4	40	Sandstone			
40	60	Gray Shale			
60	62	Iron Pirite			
62	74	Gray Shale			
74	75	Iron Pirite			
75	140	Gray Shale			
140	160	Sandstone			
160	162	Gray Shale			

7 CONTRACTOR'S OR LANDOWNER'S CERTIFICATION: This water well was (1) constructed, (2) reconstructed, or (3) plugged under my jurisdiction and was completed on (mo/day/year) 8-19-87 and this record is true to the best of my knowledge and belief. Kansas
 Water Well Contractor's License No. 138 This Water Well Record was completed on (mo/day/year) 8-20-87
 under the business name of Peterson Irrigation, Inc. by (signature) Mike Peterson

INSTRUCTIONS: Use typewriter or ball point pen. PLEASE PRESS FIRMLY and PRINT clearly. Please fill in blanks, underline or circle the correct answers. Send top three copies to Kansas Department of Health and Environment, Office of Oil Field and Environmental Geology, Regulation and Permitting Section, Topeka, Kansas 66620-7500, Telephone: 913-862-9360. Send one to WATER WELL OWNER and retain one for your records.