USE TYPEWRITER OR BALL POINT PEN-PRESS FIRMLY, PRINT CLEARLY.

WATER WELL RECORD
KSA 82a-1201-1215

Kansas Department of Health and Environment-Division of Environment
(Water well Contractors)
Topeka, Kansas 66620

1. Location of well:	County	Fraction	Section number	Township number	Range number
	Ottawa	NE 1/4 NE 1/4 NW 1/4	16	T 12 S	R 3W E/W

2. Distance and direction from nearest town or city: 1 Mi S. & 3 3/4 Mi W. of Bennington
Street address of well location if in city:

3. Owner of well: Melvin Reed
R.R. or street: Rt. 1 Bennington Kans 67422
City, state, zip code:

4. Locate with "X" in section below:

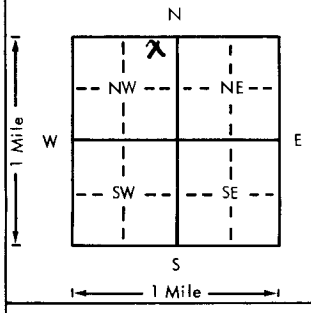

Sketch map:

6. Bore hole dia. 6 in. Completion date
Well depth 90 ft. 10/10/79

7. __ Cable tool X Rotary __ Driven __ Dug
__ Hollow rod __ Jetted __ Bored __ Reverse rotary

8. Use: X Domestic __ Public supply __ Industry
__ Irrigation __ Air conditioning __ Stock
__ Lawn __ Oil field water __ Other

9. Casing: Material
Threaded __ Welded __
RMP X PVC
Dia. 5 in. to 20 ft. depth
Dia. 4 in. to 90 ft. depth
Height: Above or below
Surface 12 in.
Weight lbs./ft.
Wall Thickness: inches or gage No. 200

In feet

5. Type and color of material	From	To
Clay, silty, tan	0	12
Shale, yellow + gray; interbedded with sandstone, fine	12	28
Shale, gray	28	54
Sandstone, fine, contains some shale, gray	54	90

(Use a second sheet if needed)

10. Screen: Manufacturer's name Hydraulic Drilling Co
Type Slots Dia. 4"
Slot/gauze 1/16" Length 7'
Set between 83 ft. and 90 ft.
ft. and ft.
Gravel pack? Y Size range of material 1/10"

11. Static water level: mo./day/yr.
22 ft. below land surface Date 10/10/79

12. Pumping level below land surfaces:
ND ft. after 2 hrs. pumping 20 g.p.m.
ft. after hrs. pumping g.p.m.
Estimated maximum yield 30 g.p.m.

13. Water sample submitted: mo./day/yr.
__ Yes X No Date

14. Well head completion:
__ Pitless adapter 12 Inches above grade

15. Well grouted? Y
With: X Neat cement __ Bentonite __ Concrete
Depth: From 3 ft. to 13 ft.

16. Nearest source of possible contamination:
ft. 100' Direction N Type Septic
Well disinfected upon completion? X Yes __ No

17. Pump: X Not installed
Manufacturer's name
Model number HP Volts
Length of drop pipe ft. capacity g.p.m.
Type:
__ Submersible __ Turbine
__ Jet __ Reciprocating
__ Centrifugal __ Other

18. Elevation:

Topography:
__ Hill
__ Slope
X Upland
__ Valley

19. Remarks:

20. Water well contractor's certification:
This well was drilled under my jurisdiction and this report is true to the best of my knowledge and belief.
Business name Hydraulic Drilling Co License No. 126
Address Salina Kans
Signed [illegible] Date 11/5/79
Authorized representative

T 12 R 3 W Sec 16 1/4 NE 1/4 NE 1/4 NW 1/4

Forward the white, blue and pink copies to the Department of Health and Environment

Form WWC-5

MI-1023