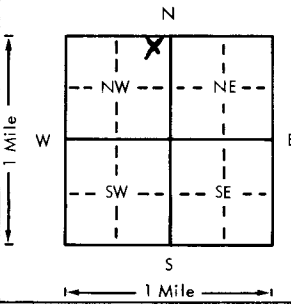


USE TYPEWRITER OR BALL POINT PEN-PRESS FIRMLY, PRINT CLEARLY.

WATER WELL RECORD
KSA 82a-1201-1215

Kansas Department of Health and Environment
Division of Environment
(Water well Contractors)
Topeka, Kansas 66620

1. Location of well: County Ottawa		Fraction NE 1/4 NE 1/4 NW 1/4		Section number 17		Township number T 12 S		Range number R 3 W E/W	
2. Distance and direction from nearest town or city: Street address of well location if in city: 1 mi S + 4 3/4 W. of Bennington				3. Owner of well: Larry Horning R.R. or street: Rt. 1 City, state, zip code: Bennington Kans, 67422					
4. Locate with "X" in section below: 				Sketch map:		6. Bore hole dia. 6 in. Completion date Oct. 8, 1979 Well depth 122 ft.			
						7. <input checked="" type="checkbox"/> Cable tool <input checked="" type="checkbox"/> Rotary <input type="checkbox"/> Driven <input type="checkbox"/> Dug <input type="checkbox"/> Hollow rod <input type="checkbox"/> Jetted <input type="checkbox"/> Bored <input type="checkbox"/> Reverse rotary			
						8. Use: <input checked="" type="checkbox"/> Domestic <input type="checkbox"/> Public supply <input type="checkbox"/> Industry <input type="checkbox"/> Irrigation <input type="checkbox"/> Air conditioning <input type="checkbox"/> Stock <input type="checkbox"/> Lawn <input type="checkbox"/> Oil field water <input type="checkbox"/> Other			
						9. Casing: Material _____ Height: <u>Above</u> or below Threaded _____ Welded _____ Surface 12 in. RMP <input checked="" type="checkbox"/> PVC _____ Weight _____ lbs./ft. Dia. 4 in. to 122 ft. depth Wall Thickness: inches or Dia. _____ in. to _____ ft. depth gage No. 200			
5. Type and color of material				From		To		10. Screen: Manufacturer's name Hydraulic Drilling Co	
Clay, silty, tan				0		10		Type slots Dia. 4"	
Sandstone, fine interbedded with shale, light gray				10		77		Slot/gauze 1/16" Length 7'	
Shale, gray				77		84		Set between 115 ft. and 122 ft.	
Shale, gray interbedded with sandstone				84		92		Gravel pack? <input checked="" type="checkbox"/> Size range of material 1/10"	
Sandstone, fine, interbedded with some shale, dark gray				92		122		11. Static water level: _____ mo./day/yr. 73 ft. below land surface Date 10/8/79	
								12. Pumping level below land surfaces: ND ft. after 2 hrs. pumping 15 g.p.m. _____ ft. after _____ hrs. pumping _____ g.p.m. Estimated maximum yield 25 g.p.m.	
								13. Water sample submitted: _____ mo./day/yr. Yes <input checked="" type="checkbox"/> No _____ Date _____	
								14. Well head completion: _____ Pitless adapter 12 Inches above grade	
								15. Well grouted? <input checked="" type="checkbox"/> With: <input checked="" type="checkbox"/> Neat cement _____ Bentonite _____ Concrete _____ Depth: From 3 ft. to 13 ft.	
								16. Nearest source of possible contamination: ft. 80' Direction W Type septic Well disinfected upon completion? <input checked="" type="checkbox"/> Yes _____ No _____	
								17. Pump: <input checked="" type="checkbox"/> Not installed Manufacturer's name _____ Model number _____ HP _____ Volts _____ Length of drop pipe _____ ft. capacity _____ g.p.m. Type: <input type="checkbox"/> Submersible _____ Turbine _____ <input type="checkbox"/> Jet _____ Reciprocating _____ <input type="checkbox"/> Centrifugal _____ Other _____	
								(Use a second sheet if needed)	
18. Elevation:		19. Remarks:		20. Water well contractor's certification: This well was drilled under my jurisdiction and this report is true to the best of my knowledge and belief. Hydraulic Drilling Co 126 Business name _____ License No. _____ Address Topeka, Kansas Signed D. J. Fent Date 11/5/79 Authorized representative					
Topography: <input type="checkbox"/> Hill <input type="checkbox"/> Slope <input checked="" type="checkbox"/> Upland <input type="checkbox"/> Valley									

Forward the white, blue and pink copies to the Department of Health and Environment

Form WWC-5

T 12 S R 3 W E/W 12 NE 1/4 NW 1/4