


USE TYPEWRITER OR BALL POINT PEN—PRESS FIRMLY, PRINT CLEARLY.

WATER WELL RECORD
KSA 82a-1201-1215

Kansas Department of Health and Environment—Division of Environment
(Water well Contractors)
Topeka, Kansas 66620

1. Location of well:		County <i>Ottawa</i>	Fraction <i>NE 1/4 NE 1/4 NE 1/4</i>	Section number <i>18</i>	Township number <i>T 12 S R 3</i>	Range number <i>3</i>	<i>EW</i>
Distance and direction from nearest town or city: Street address of well location if in city:				3. Owner of well: <i>Nick Koster</i> R.R. or street: <i>Rt 1</i> City, state, zip code: <i>Bennington Kans.</i>			
4. Locate with "X" in section below:		Sketch map:		6. Bore hole dia. <i>4</i> in. Completion date <i>3-25-76</i> Well depth <i>127</i> ft.			
				7. Cable tool <input checked="" type="checkbox"/> Rotary <input type="checkbox"/> Driven <input type="checkbox"/> Dug <input type="checkbox"/> Hollow rod <input type="checkbox"/> Jetted <input type="checkbox"/> Bored <input type="checkbox"/> Reverse rotary			
5. Type and color of material		From	To	8. Use: <input checked="" type="checkbox"/> Domestic <input type="checkbox"/> Public supply <input type="checkbox"/> Industry <input type="checkbox"/> Irrigation <input type="checkbox"/> Air conditioning <input type="checkbox"/> Stock <input type="checkbox"/> Lawn <input type="checkbox"/> Oil field water <input type="checkbox"/> Other			
<i>Dakota fm.?</i>				9. Casing: Material <i>PVC</i> Height <i>Above</i> or below Threaded <input type="checkbox"/> Welded <input type="checkbox"/> Surface <i>12</i> in. RMP <input type="checkbox"/> PVC <input type="checkbox"/> Weight <input type="checkbox"/> lbs./ft. Dia. <i>4</i> in. to <i>127</i> ft. depth Wall Thickness: inches or Dia. <input type="checkbox"/> in. to <input type="checkbox"/> ft. depth gage No. <i>0.237</i>			
<i>Sandstone, med-fine, yellow; interbedded with little clay lt. gray mottled yellow</i>		<i>0</i>	<i>65</i>	10. Screen: Manufacturer's name <i>Shap</i> Type <i>slotted</i> Dia. <i>4</i> Slot/gauze <i>1/16"</i> Length <i>15'</i> Set between <i>112</i> ft. and <i>127</i> ft. ft. and <input type="checkbox"/> ft. Gravel pack? <input checked="" type="checkbox"/> Size range of material <i>2 mesh</i>			
<i>Shale, clayey, blue-gray mottled yellow</i>		<i>65</i>	<i>74</i>	11. Static water level: <input type="checkbox"/> mo./day/yr. <i>77</i> ft. below land surface Date <i>3-29-76</i>			
<i>Kiowa fm</i>				12. Pumping level below land surfaces: <input type="checkbox"/> ft. after <i>3</i> hrs. pumping <i>5</i> g.p.m. <input type="checkbox"/> ft. after <input type="checkbox"/> hrs. pumping <input type="checkbox"/> g.p.m. Estimated maximum yield <i>15</i> g.p.m.			
<i>Sandstone, fine, yellow</i>		<i>74</i>	<i>90</i>	13. Water sample submitted: <input type="checkbox"/> mo./day/yr. Yes <input checked="" type="checkbox"/> No <input type="checkbox"/> Date <input type="checkbox"/>			
<i>Shale, dark gray</i>		<i>90</i>	<i>103</i>	14. Well head completion: <input type="checkbox"/> Pitless adapter <i>12</i> inches above grade			
<i>Sandstone, v f-fine, silty, white, pyritic</i>		<i>103</i>	<i>105</i>	15. Well grouted? <input checked="" type="checkbox"/> With: <input type="checkbox"/> Neat cement <input checked="" type="checkbox"/> Bentonite <input type="checkbox"/> Concrete Depth: From <i>3</i> ft. to <i>13</i> ft.			
<i>" " " interbedded with shale</i>		<i>105</i>	<i>113</i>	16. Nearest source of possible contamination: ft. <input type="checkbox"/> Direction <input type="checkbox"/> Type <input type="checkbox"/> Well disinfected upon completion? <input checked="" type="checkbox"/> Yes <input type="checkbox"/> No			
<i>Shale, dark blue-gray</i>		<i>113</i>	<i>118</i>	17. Pump: <input checked="" type="checkbox"/> Not installed Manufacturer's name <input type="checkbox"/> Model number <input type="checkbox"/> HP <input type="checkbox"/> Volts <input type="checkbox"/> Length of drop pipe <input type="checkbox"/> ft. capacity <input type="checkbox"/> g.p.m. Type: <input type="checkbox"/> Submersible <input type="checkbox"/> Turbine <input type="checkbox"/> Jet <input type="checkbox"/> Reciprocating <input type="checkbox"/> Centrifugal <input type="checkbox"/> Other			
<i>Sandstone, light gray, interbedded with shale, dark gray, some pyrite</i>		<i>118</i>	<i>127</i>	18. Elevation: <i>1320</i> 19. Remarks: Topography: <input checked="" type="checkbox"/> Hill <input type="checkbox"/> Slope <input type="checkbox"/> Upland <input type="checkbox"/> Valley			
(Use a second sheet if needed)				20. Water well contractor's certification: This well was drilled under my jurisdiction and this report is true to the best of my knowledge and belief. <i>Shaulie Stulig Co</i> <i>126</i> Business name License No. Address <i>Salina Kans</i> Signed <i>O. J. Tent</i> Date <i>5-17-76</i> Authorized representative			

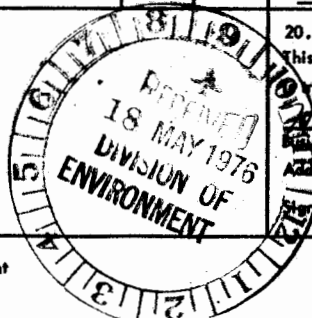

Forward the white, blue and pink copies to the Department of Health and Environment

Form WWC-5