


1 LOCATION OF WATER WELL: County: Ottawa Fraction: SW 1/4 NW 1/4 NW 1/4 Section Number: 19 Township Number: T 12 S Range Number: R 3 (W)

Distance and direction from nearest town or city street address of well if located within city?
3 miles East & 1 3/4 Mile North of Culver, KS

2 WATER WELL OWNER: Erhsel Steckman
 RR#, St. Address, Box # : R.R. #1 Board of Agriculture, Division of Water Resources
 City, State, ZIP Code: Culver, KS 67435 Application Number:

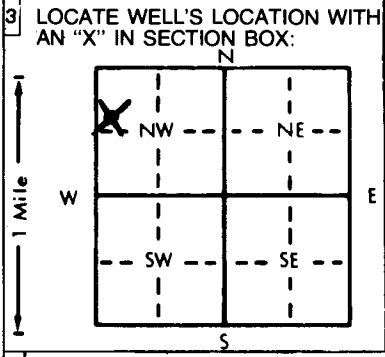

4 DEPTH OF COMPLETED WELL: 117 ft. ELEVATION: 713.23
 Depth(s) Groundwater Encountered: 1.43 ft. 2. ft. 3. ft.
 WELL'S STATIC WATER LEVEL: 43 ft. below land surface measured on mo/day/yr 2/1/90
 Pump test data: Well water was ft. after hours pumping gpm
 Est. Yield 2 1/2 - 3 gpm: Well water was 110 ft. after 1 hours pumping 3 gpm
 Bore Hole Diameter: 8 in. to 122 ft., and in. to ft.
 WELL WATER TO BE USED AS:
 5 Public water supply 8 Air conditioning 11 Injection well
1 Domestic 3 Feedlot 6 Oil field water supply 9 Dewatering 12 Other (Specify below)
2 Irrigation 4 Industrial 7 Lawn and garden only 10 Monitoring well
 Was a chemical/bacteriological sample submitted to Department? Yes No X; If yes, mo/day/yr sample was submitted
 Water Well Disinfected? Yes X No

5 TYPE OF BLANK CASING USED:
 1 Steel 3 RMP (SR) 5 Wrought iron 8 Concrete tile CASING JOINTS: Glued X Clamped
2 PVC 4 ABS 6 Asbestos-Cement 9 Other (specify below) Welded
 7 Fiberglass Threaded
 Blank casing diameter 5 in. to 97 ft., Dia in. to ft., Dia in. to ft.
 Casing height above land surface: 12 in., weight 2.91 lbs./ft. Wall thickness or gauge No. 265
 TYPE OF SCREEN OR PERFORATION MATERIAL:
 1 Steel 3 Stainless steel 5 Fiberglass 7 PVC 10 Asbestos-cement
 2 Brass 4 Galvanized steel 6 Concrete tile 8 RMP (SR) 11 Other (specify)
 9 ABS 12 None used (open hole)
 SCREEN OR PERFORATION OPENINGS ARE:
 1 Continuous slot 3 Mill slot 5 Gauzed wrapped 8 Saw cut 11 None (open hole)
 2 Louvered shutter 4 Key punched 6 Wire wrapped 9 Drilled holes
 7 Torch cut 10 Other (specify)
 SCREEN-PERFORATED INTERVALS: From 97 ft. to 117 ft., From ft. to ft.
 From ft. to ft., From ft. to ft.
 GRAVEL PACK INTERVALS: From 25 ft. to 117 ft., From ft. to ft.
 From ft. to ft., From ft. to ft.

6 GROUT MATERIAL: 1 Neat cement 2 Cement grout 3 Bentonite 4 Other
 Grout Intervals: From 0 ft. to 25 ft., From ft. to ft., From ft. to ft.
 What is the nearest source of possible contamination:
 1 Septic tank 4 Lateral lines 7 Pit privy 10 Livestock pens 14 Abandoned water well
 2 Sewer lines 5 Cess pool 8 Sewage lagoon 11 Fuel storage 15 Oil well/Gas well
 3 Watertight sewer lines 6 Seepage pit 9 Feedyard 12 Fertilizer storage 16 Other (specify below)
 13 Insecticide storage
 Direction from well? Southeast How many feet? 70ft

FROM	TO	LITHOLOGIC LOG	FROM	TO	PLUGGING INTERVALS
0	3	Top Soil			
3	7	Gray Clay			
7	20	Brown Silty Clay			
20	26	Green Shale			
26	65	Shale "Gray"			
65	66	Iron Pirite			
66	98	Gray Shale			
98	122	Sandstone with shale layers			

7 CONTRACTOR'S OR LANDOWNER'S CERTIFICATION: This water well was (1) constructed, (2) reconstructed, or (3) plugged under my jurisdiction and was completed on (mo/day/year) 2-1-90 and this record is true to the best of my knowledge and belief. Kansas Water Well Contractor's License No. 138 This Water Well Record was completed on (mo/day/yr) 2-8-90 under the business name of Peterson Irrigation, Inc. by (signature) Mike Peterson