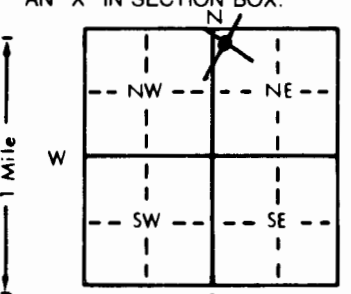


1 LOCATION OF WATER WELL: Fraction NW 1/4 NW 1/4 NE 1/4 Section Number 21 Township Number T 12 S Range Number R 3  
 County: Ottawa

Distance and direction from nearest town or city street address of well if located within city?

3 1/2 Miles West & 2 miles South of Bennington

2 WATER WELL OWNER: David Swisher Board of Agriculture, Division of Water Resources  
 RR#, St. Address, Box # : 510 N. Nelson Application Number:  
 City, State, ZIP Code : Bennington, KS 67422

3 LOCATE WELL'S LOCATION WITH AN "X" IN SECTION BOX:  4 DEPTH OF COMPLETED WELL: 62 ft. ELEVATION:  
 Depth(s) Groundwater Encountered 1. 13 ft. 2. ft. 3. ft.  
 WELL'S STATIC WATER LEVEL 1.3 ft. below land surface measured on mo/day/yr 6-20-94  
 Pump test data: Well water was ft. after hours pumping gpm  
 Est. Yield 5 gpm: Well water was 4.0 ft. after 1 hours pumping 6 gpm  
 Bore Hole Diameter: 8 in. to 10.5 in. and in. to in.  
 WELL WATER TO BE USED AS: 5 Public water supply 8 Air conditioning 11 Injection well  
 1 Domestic 3 Feedlot 6 Oil field water supply 9 Dewatering 12 Other (Specify below)  
 2 Irrigation 4 Industrial 7 Lawn and garden only 10 Monitoring well  
 Was a chemical/bacteriological sample submitted to Department? Yes No X; If yes, mo/day/yr sample was submitted  
 Water Well Disinfected? Yes X No

5 TYPE OF BLANK CASING USED: 5 Wrought iron 8 Concrete tile CASING JOINTS: Glued X Clamped  
 1 Steel 3 RMP (SR) 6 Asbestos-Cement 9 Other (specify below) Welded  
 2 PVC 4 ABS 7 Fiberglass Threaded  
 Blank casing diameter 5 in. to 15 ft., Dia. 20 in. to 52 ft., Dia. in. to ft.  
 Casing height above land surface 12 in., weight 2.37 lbs./ft. Wall thickness or gauge No. 21.4  
 TYPE OF SCREEN OR PERFORATION MATERIAL: 7 PVC 10 Asbestos-cement  
 1 Steel 3 Stainless steel 5 Fiberglass 8 RMP (SR) 11 Other (specify)  
 2 Brass 4 Galvanized steel 6 Concrete tile 9 ABS 12 None used (open hole)  
 SCREEN OR PERFORATION OPENINGS ARE: 5 Gauzed wrapped 8 Saw cut 11 None (open hole)  
 1 Continuous slot 3 Mill slot 6 Wire wrapped 9 Drilled holes  
 2 Louvered shutter 4 Key punched 7 Torch cut 10 Other (specify)  
 SCREEN-PERFORATED INTERVALS: From 15 ft. to 20 ft., From ft. to ft.  
 From 52 ft. to 62 ft., From ft. to ft.  
 GRAVEL PACK INTERVALS: From 15 ft. to 62 ft., From ft. to ft.  
 From ft. to ft., From ft. to ft.

6 GROUT MATERIAL: 1 Neat cement 2 Cement grout 3 Bentonite 4 Other  
 Grout Intervals: From 0 ft. to 15 ft., From ft. to ft., From ft. to ft.  
 What is the nearest source of possible contamination: 10 Livestock pens 14 Abandoned water well  
 1 Septic tank 4 Lateral lines 7 Pit privy 11 Fuel storage 15 Oil well/Gas well  
 2 Sewer lines 5 Cess pool 8 Sewage lagoon 12 Fertilizer storage 16 Other (specify below)  
 3 Watertight sewer lines 6 Seepage pit 9 Feedyard 13 Insecticide storage  
 Direction from well? Northeast How many feet? 100ft

FROM	TO	LITHOLOGIC LOG	FROM	TO	PLUGGING INTERVALS
0	2	Top Soil			
2	4	Brown Clay			
4	19	Fine Sand & Small Rock			
19	43	Fine Sand & Gray Clay			
43	62	Sandstone & Clay			
62	105	Gray Shale			

7 CONTRACTOR'S OR LANDOWNER'S CERTIFICATION: This water well was (1) constructed, (2) reconstructed, or (3) plugged under my jurisdiction and was completed on (mo/day/year) 6-29-94 and this record is true to the best of my knowledge and belief. Kansas Water Well Contractor's License No. 138 This Water Well Record was completed on (mo/day/yr) 7-18-94 under the business name of Peterson Irrigation Inc. by (signature) Mike Peters